

TOWN OF LEXINGTON—DEPT. OF PUBLIC WORKS

SEWER DIVISION

DATE

NO.


The undersigned applies for the construction of a particular sewer connecting No.
Street and hereby agrees to comply with the Rules and Regulations governing the construction and use of Particular
Sewers, as now or at any future time established by the Board of Selectmen.

Am't of estimate \$.....

Am't Paid \$.....

..... Owner

Sketch of Service Here

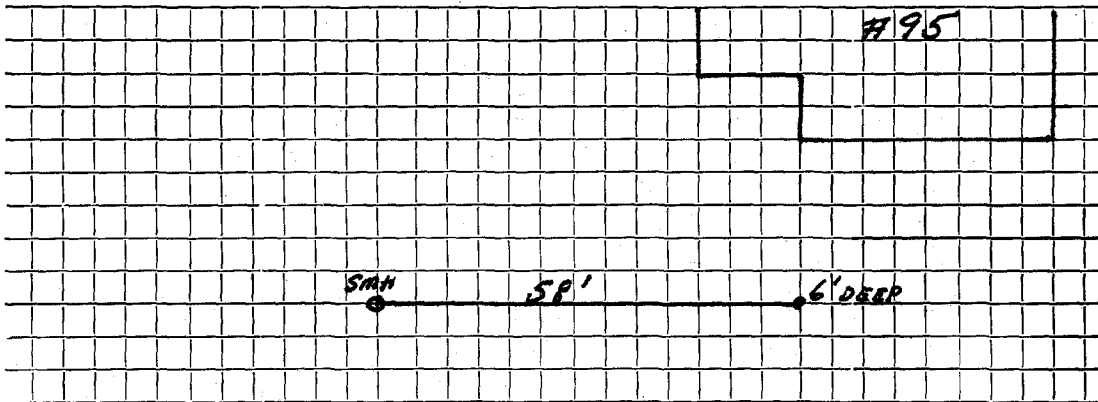

Connection made in Street.

Work completed 19..

Remarks:

Name Ray A. Campbell

Service No. 45

Address 95 Gleason Road

Location

Kind of Pipe

Size

Size of Main

~~Repair/ Renewal~~ - New Service Work Order # 808

Location NOV 19 1973-

Date	Material	Amount	Total	Date	NON-CHARGE	Amount
5/18/'73	Labor	\$36.64		5/18/'73	Labor	\$109.92
	, Labor	17.90	\$54.54	5/22/'73	"	50.84
	10% O.H.	5.45	\$59.99			\$ 160.76
27	1/2' 6" Transite @.99		27.23		20' 6" Transite @99¢/ft.	19.80
	1 Donut		3.05		1 Bag Cement	2.00
	1 Yd. Loam		5.00		4' - 8" Clay @.70	2.80
	2 lbs. grass Seed		1.90		2 Ton 3/4" Stone	3.20
	1/4 Ton Hot Top		2.00		1 Yd. Loam	5.00
	2 Hours Truck @3.00		6.00		2 lbs. seed	1.90
	1 Hr. Town Shovel @6.50		6.50		1-1/2 Ton Hot Top	12.00
	1 Hr. Pickup		1.50		2 Hrs. Pickup @1.50	3.00
			<u>\$139.17</u>		2 Hrs. Trucking @3.00	6.00
					1 Hr. Compressor	5.00
					2-1/2 Hrs. Town Shovel @6.50	19.50
5-18-'73	Deposit	288.00				
11-19-73	Retund	144.85				
		143.15				\$240.96

DATE _____

TOWN OF LEXINGTON — BOARD OF PUBLIC WORKS

SEWER DIVISION

Sketch of Service Here

A large grid of graph paper, consisting of 20 columns and 20 rows, intended for sketching service details.

Connection made in Street. Work completed

Remarks:
.....
.....