

Name Mrs. Alice M. Ballard

Service No. 83 290

Address 12 Glen Road

Location

Kind of Pipe

Size

Size of Main

~~Repair~~—Renewal—New Service

Location

Date	Material	Amount	Total	Date	Amount
10-23-25 for 132.25	80' 6" V.C. Pipe @.30	24 00			
	4' 24" V.C. Pipe @1.25	6 00		Nov 3 1955 - Cash	132.25
	Trucking	1 25			
	1 M.H. Cover & Frame	<u>19 35</u>	50 60		
10/11	106 Hrs. Labor @.55	58 30			
to 10/16	13 " " @.70	9 10			
	6 " " @.60	<u>3 60</u>	71 00		
	15% Overhead		<u>10 65</u>		
10-21-66	Renewal		132 25		
	20' 6" Transite				
	Labor				
	2 6" Collars			8-10-66	ROOTS
	1 6" Adapter			8-19-66	ROOTS
				4-18-72	ROOTS

5
21
2
7W
150.
17

TOWN OF LEXINGTON—BOARD OF PUBLIC WORKS
SEWER DIVISION

DATE 10/8/25

NO. 12 Glenn Road

The undersigned applies for the construction of a particular sewer connecting No. 12 Glenn Road Street and hereby agrees to comply with the Rules and Regulations governing the construction and use of Particular Sewers, as now or at any future time established by the Board of Selectmen.


Am't. of Estimate \$ 90.00 *This estimate to enter through front*
175.00 *if we go thru side*

Am't. Paid \$ _____

Ballard

Mrs. Alice M. Ballard Owner

Sketch of Service Here

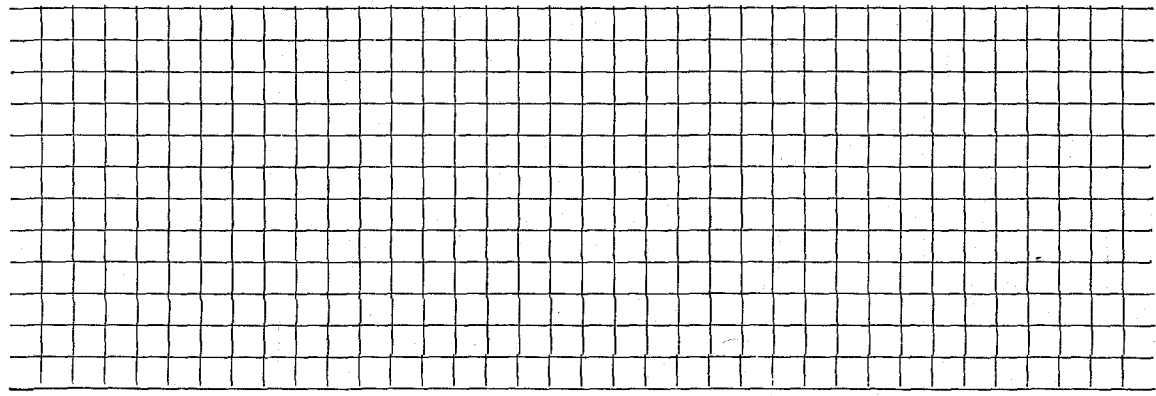

Connection made in _____ Street. Work completed _____ 19

Remarks: