

Name C. Russell Smallman

Service No. 132

Address 21 Glen Road South

Location Lot Plot #40

Kind of Pipe

Size

Size of Main

~~Repair/Removal~~ New Service DeFlice #1722

Location JUL 27 1970

Date	Material	Amount	Total	Date	Amount
9/25/69	30' 6" Transite Pipe @	9.00	\$ 270 00	11-6-69	270 00
10/5/70	49' 6" Transite pipe			9-25-69	
	3' 4" Cast Iron pipe			30' 6" Transite	

Deposit

270 00


9-25-69

30' 6" Transite

DATE _____

TOWN OF LEXINGTON — BOARD OF PUBLIC WORKS
SEWER DIVISION

Sketch of Service Here **21**

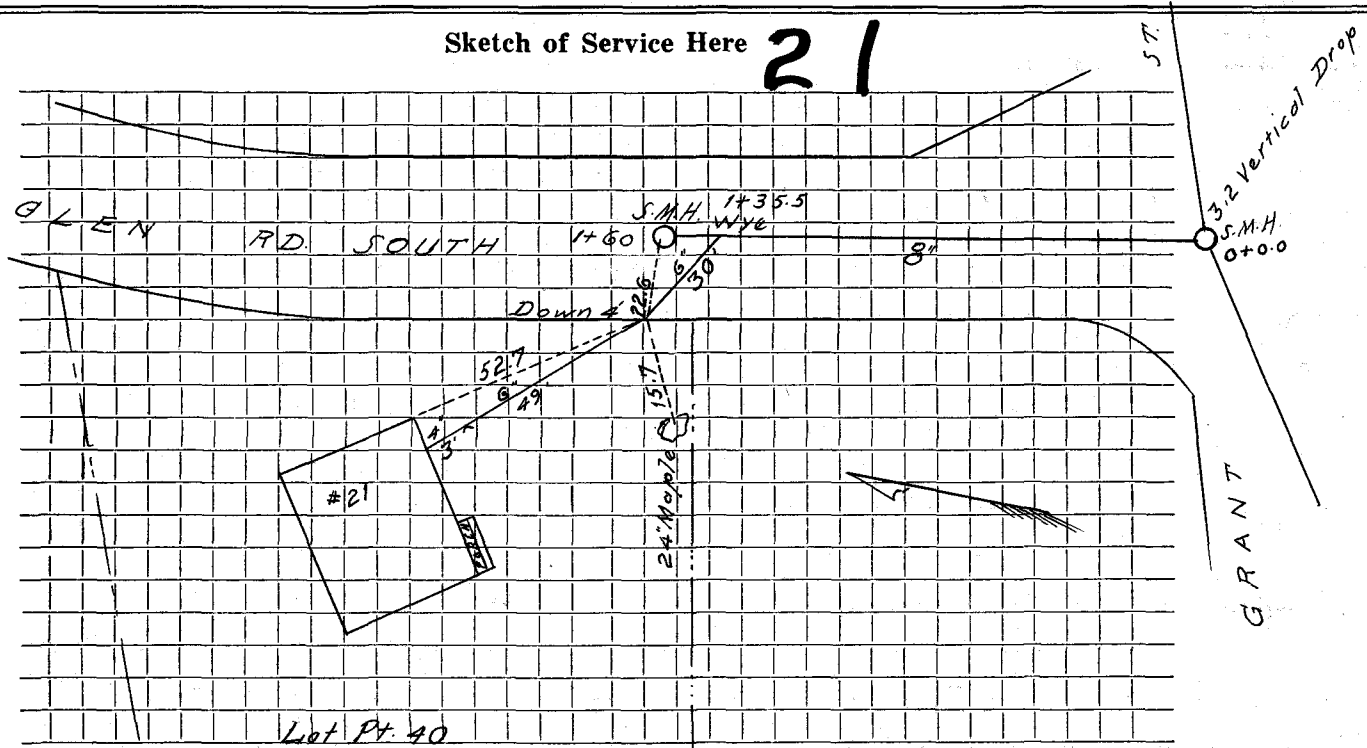

Connection made in Street. Work completed

Remarks:
.....
.....