

Name

Service No.

Address #14 Glen Rd South

Location

Kind of Pipe

Size

Size of Main

Repair—Renewal—New Service


Location

Date	Material	Amount	Total	Date	Amount
7/25/80	27 LF of 6" A.C.P. @ 14.00/ft		\$ 378.00		
9:705	SERVICE CONNECTED			7-25-80	
	6x6 A.C. to PVC FERNCO			27' 6" A.C.P.	
	4x6 C.I. to PVC FERNCO				
	1- 6" 22° PVC BEND				
	31.5' - 6" PVC PIPE				

DATE _____

TOWN OF LEXINGTON — BOARD OF PUBLIC WORKS
SEWER DIVISION

Sketch of Service Here **14**

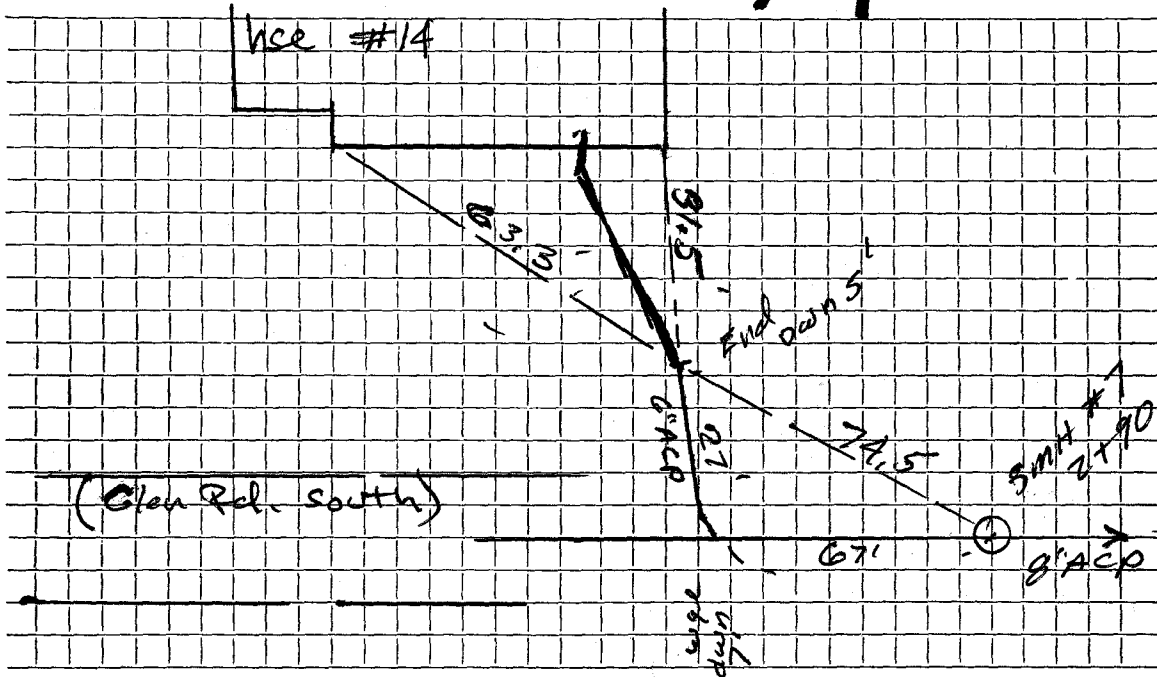

Connection made in Colen Rd. South Street Work completed

Remarks:
.....
.....