

Name Istvan L. Ver

Service No. 24

Address 10 Glenn Road

Location

Kind of Pipe

Size

Size of Main

Repair—Renewal—New Service *WO # 665*

Location


Date	Material	Amount	Total	Date	Amount
4/13/73	73' 6" transite			4-5-73	300 00
	10' 4" C.I.			10-13-73	14 25
					585 75
4/6/73	Labor	109 92			
	10% O.H.	10 99	120 91		
	10' 6" transite		9 00		
	1 22 $\frac{1}{2}$ " transite elbow		6 83	NO CHARGE	
	2 5'x6" nipple @	1 27	12 70	4/5/73	Labor 54 82
	1 6" cap		1 77		4 hours trucking 12 00
	1 bag cement		2 00		$\frac{1}{2}$ hour compressor <u>2 50</u>
	patch street 8x17		90 66		69 32
	patch sidewalk 7x5		23 88		
	6 hours trucking @	3 00	<u>18 00</u>		
			285 75		

DATE _____

TOWN OF LEXINGTON — BOARD OF PUBLIC WORKS

SEWER DIVISION

Sketch of Service Here **10**

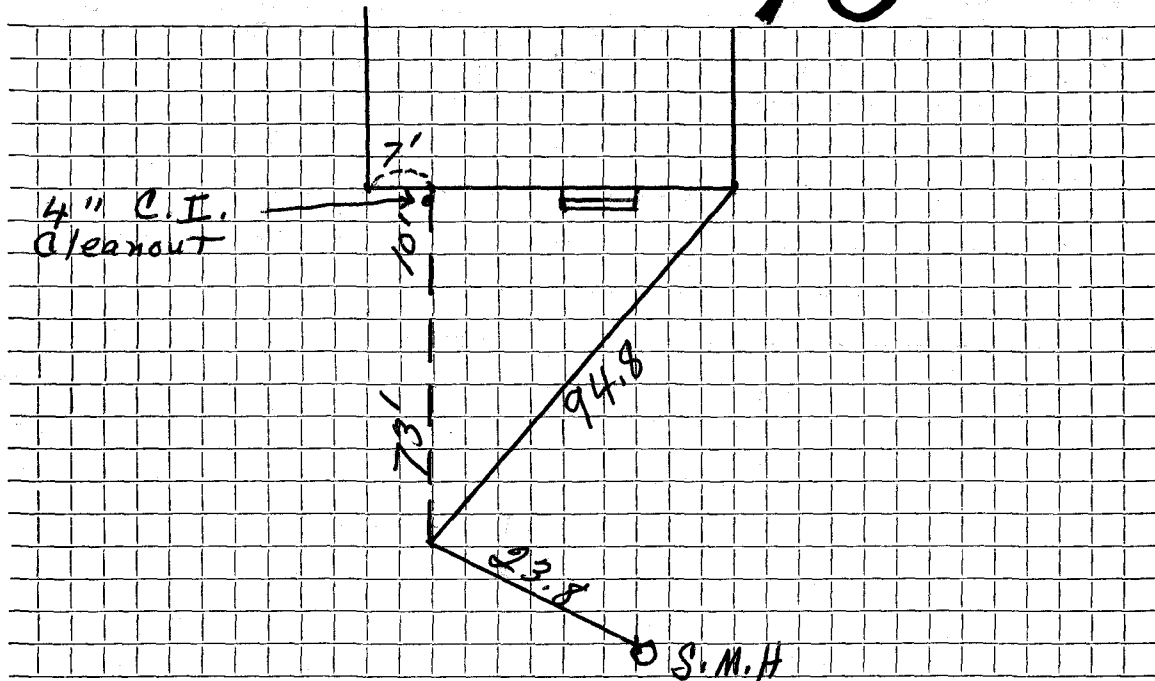

Connection made in Street. Work completed

Remarks:
.....
.....