

Name Duffy Bros.

Service No.

Address 11 Goffe Road

Location

Kind of Pipe

Size

Size of Main

Repair—Renewal—New Service

Bonanno #2102

Bonanno #1107


Location

Date	Material	Amount	Total	Date	Amount
7/30/68	32' 6" Transite				
5/28/72	43' 6" Transite pipe				
	10' 4" Cast Iron pipe			7-30-68	
				32' 6" Transite	

DATE _____

TOWN OF LEXINGTON — BOARD OF PUBLIC WORKS
SEWER DIVISION

Sketch of Service Here

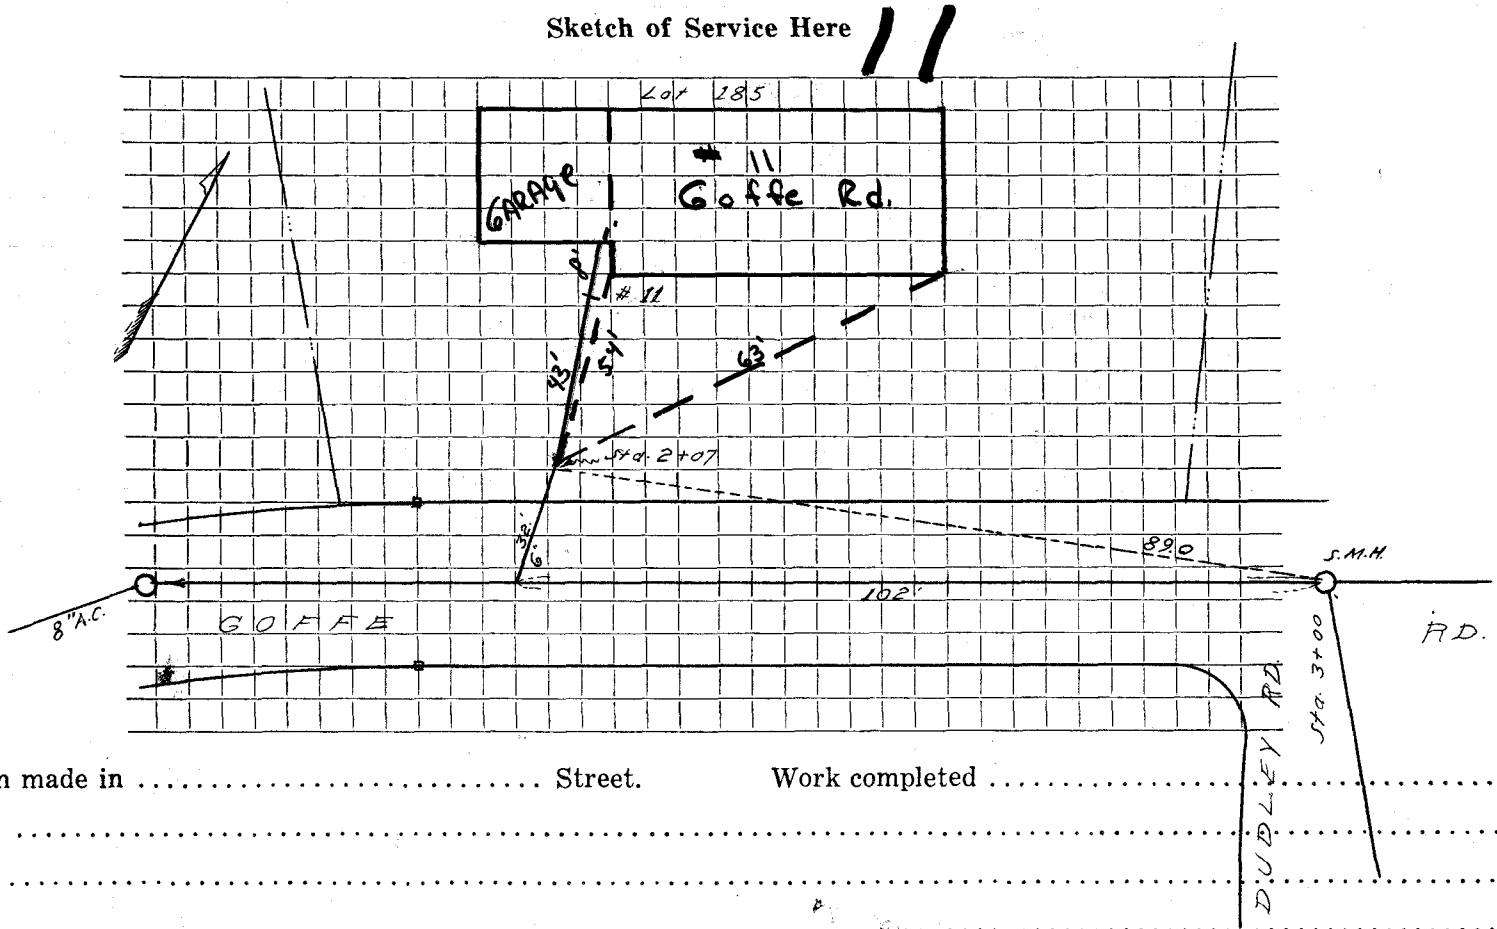

Connection made in Street. Work completed

Remarks: