

DATE _____


TOWN OF LEXINGTON — BOARD OF PUBLIC WORKS

SEWER DIVISION

Sketch of Service Here

9

A.C. Lot 186

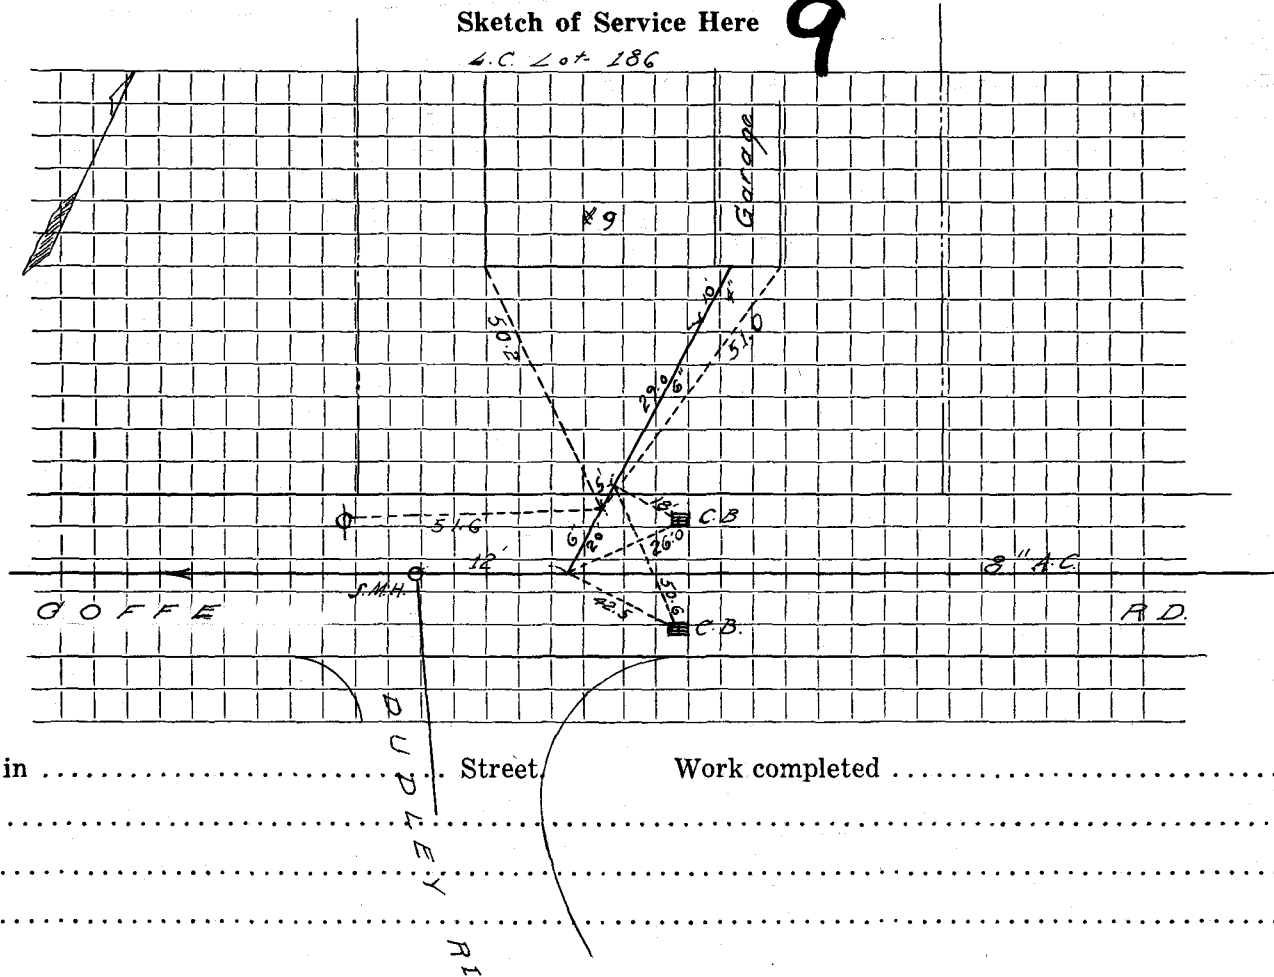

Connection made in Street. Work completed

Remarks:
.....
.....