

Name **48 HOLDEN AVE , SANTO CNST.**

Service No.

Address

Location

Kind of Pipe

Size

Size of Main

Repair—Renewal—~~New~~ Service


Location

Date	Material	Amount	Total	Date	Amount
4/24/19	6" SDR	~75 LF			
	22° BEND PVC	1			
	22° SWEEP PVC	1			
	6" CLEAN OUT	1			
	6" SPL RISE				
	6" TEE W/6 PVC				
	6" CAP PVC				
	* CONNECT TO STUD				
	FEE	\$ 1,250			

DATE 4/24/19

TOWN OF LEXINGTON — BOARD OF PUBLIC WORKS  
SEWER DIVISION

Sketch of Service Here

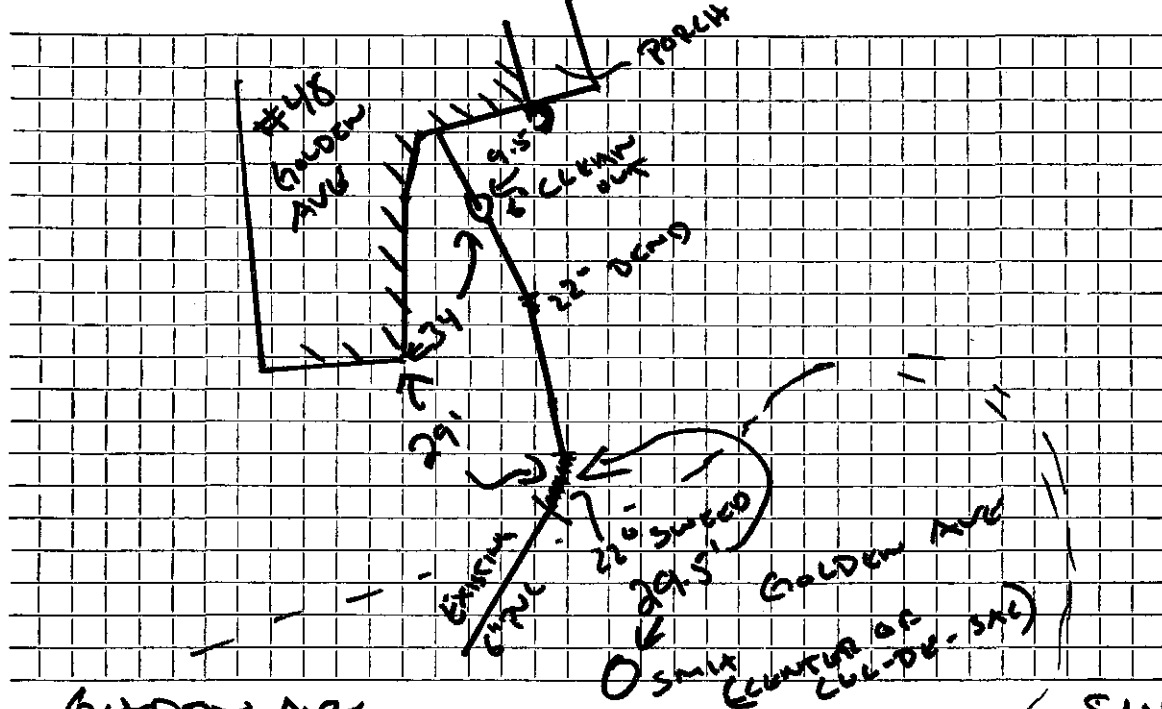

Connection made in GOLDEN AVE Street. Work completed SANTO CONSTR...

Remarks: SEPTIC ABANDONMENT  
CONTRACTOR PAID STUD REF TO COUNCILOR GRAY STUD