




P.G.H.

DATE 11/8/95

TOWN OF LEXINGTON — BOARD OF PUBLIC WORKS

SEWER DIVISION

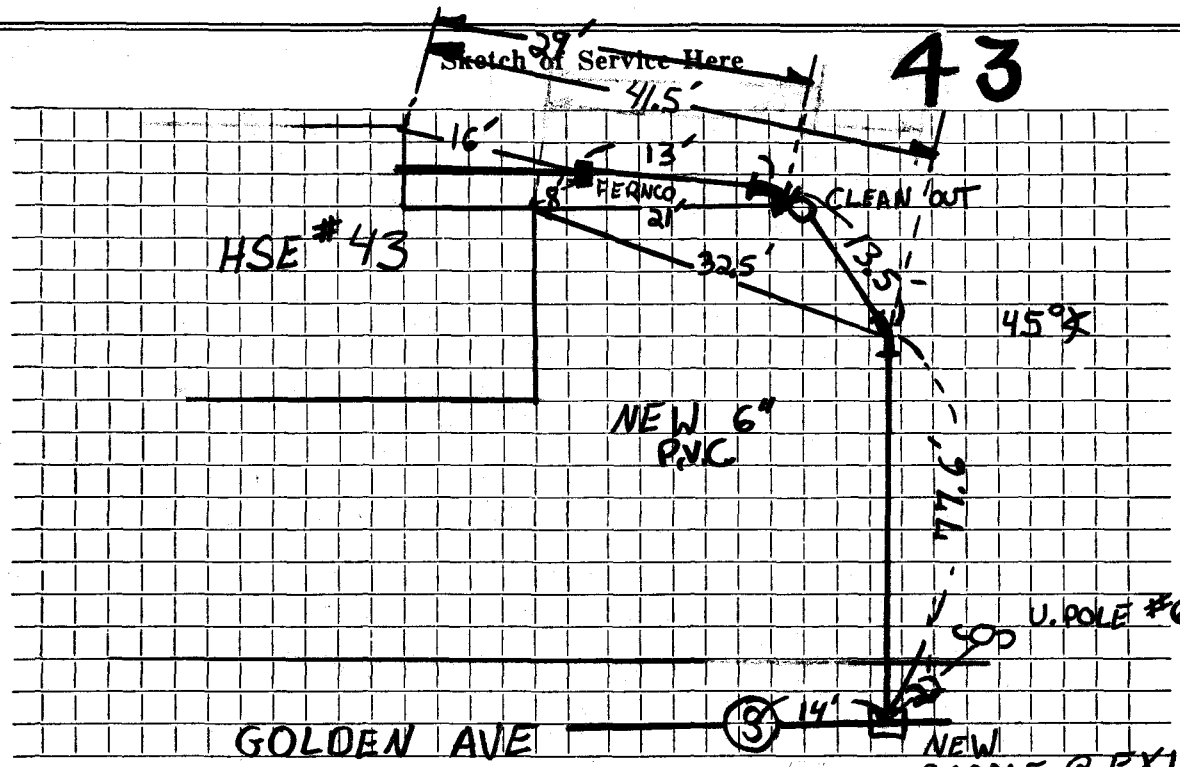

Connection made in ..... Street. Work completed .....

Remarks: CREW: 1 OPERATOR  
2 WORKERS