


DATE MAY 5, 1983

TOWN OF LEXINGTON — BOARD OF PUBLIC WORKS
SEWER DIVISION

Sketch of Service Here

44

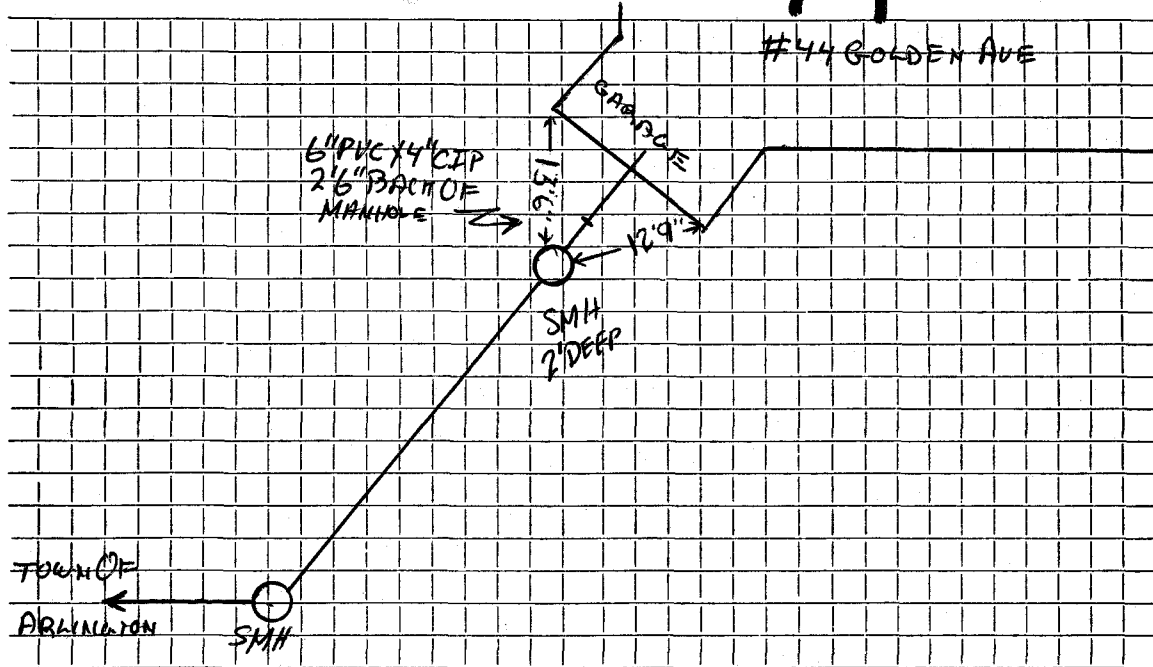

Connection made in GOLDEN AVE Street. Work completed MAY 5, 1983

Remarks: SEWER CONNECTION MADE IN SMH - TOWN OF ARLINGTON SEWER