


DATE 3.11.98

TOWN OF LEXINGTON — BOARD OF PUBLIC WORKS
SEWER DIVISION

Sketch of Service Here

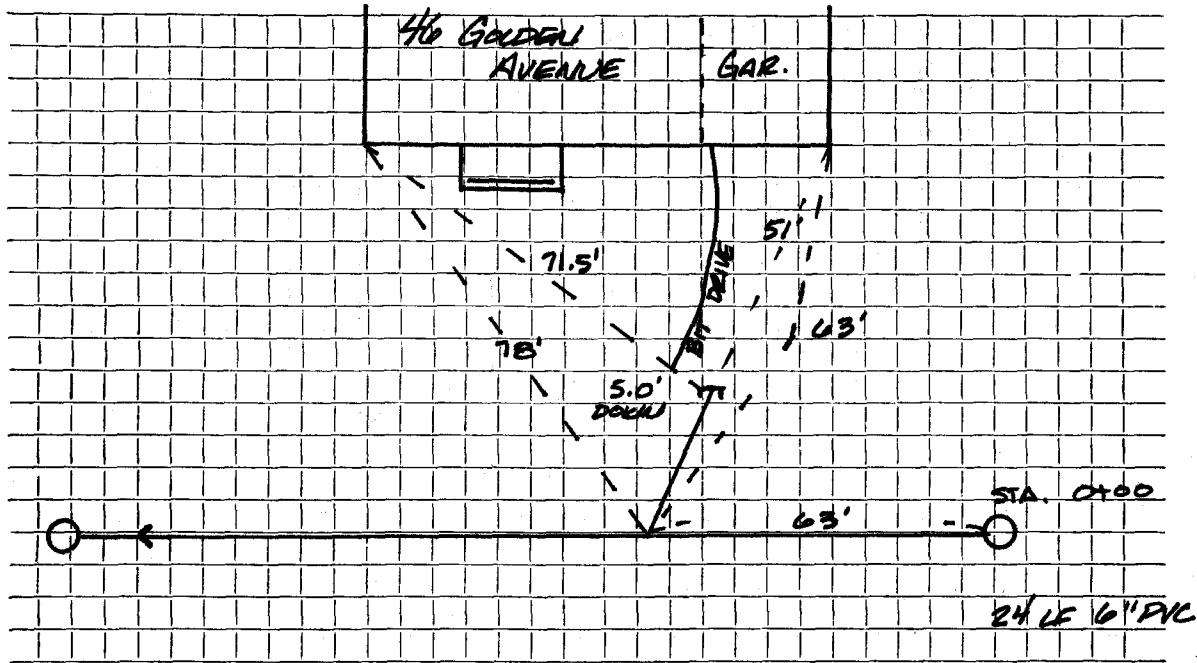

Connection made in GOLDEN AVENUE Street Work completed CONTRACT 97-4

Remarks:
.....
.....