

Name

Service No.

Address

47 Golden Ave

Location

Kind of Pipe

Size

Size of Main

Repair—Renewal—New Service

Location

Date

Material

Amount

Total

Date

Amount

9-19-02

4x6 PVC to CI Franco
6x6x4 wye cleanouts
4x4 CI to PVC Franco
6x6x4 wye
2- 6" 22° Long sweeps
1- 6" 45° Long sweep


12-4-97

18-6" PVC

DATE _____

TOWN OF LEXINGTON — BOARD OF PUBLIC WORKS
SEWER DIVISION

Sketch of Service Here

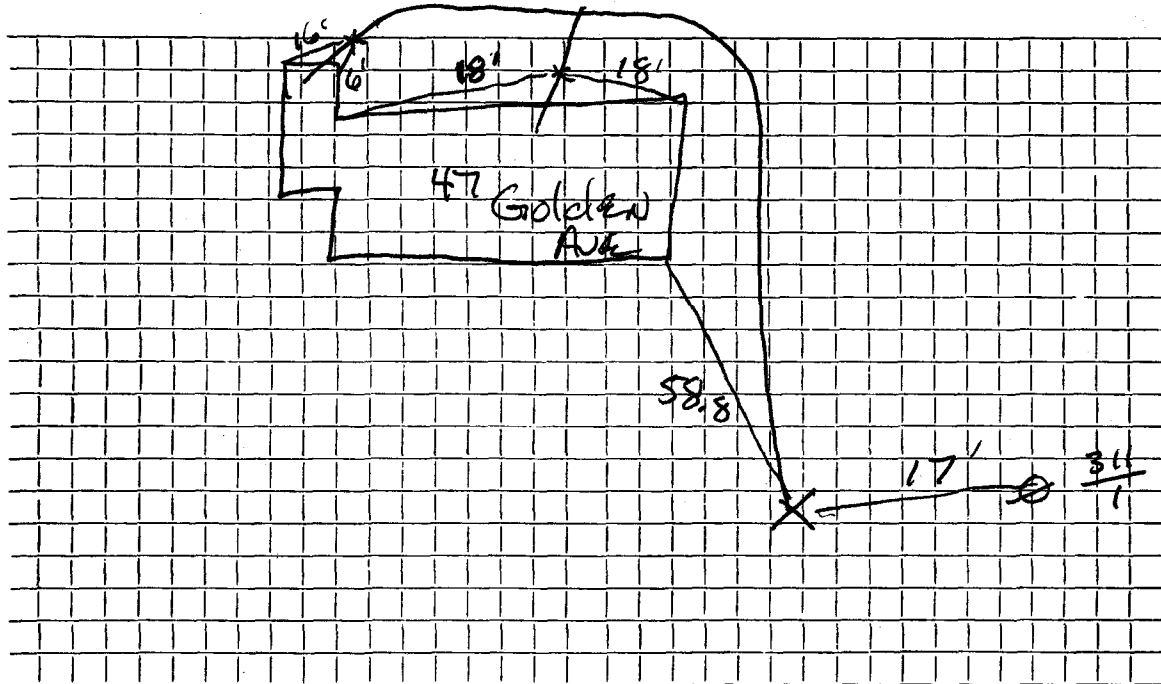

Connection made in Street. Work completed

Remarks:

.....

.....