

Name

Service No.

Address

5 Goodwin Rd

Location

Kind of Pipe

Size

Size of Main

Repair—Renewal—New Service

Location

Date

Material

Amount

Total

Date

Amount

Sewer Service Connected to Hanes R St.  
From Goodwin Rd Through Easement.


DATE \_\_\_\_\_

TOWN OF LEXINGTON — BOARD OF PUBLIC WORKS

SEWER DIVISION

Sketch of Service Here

5

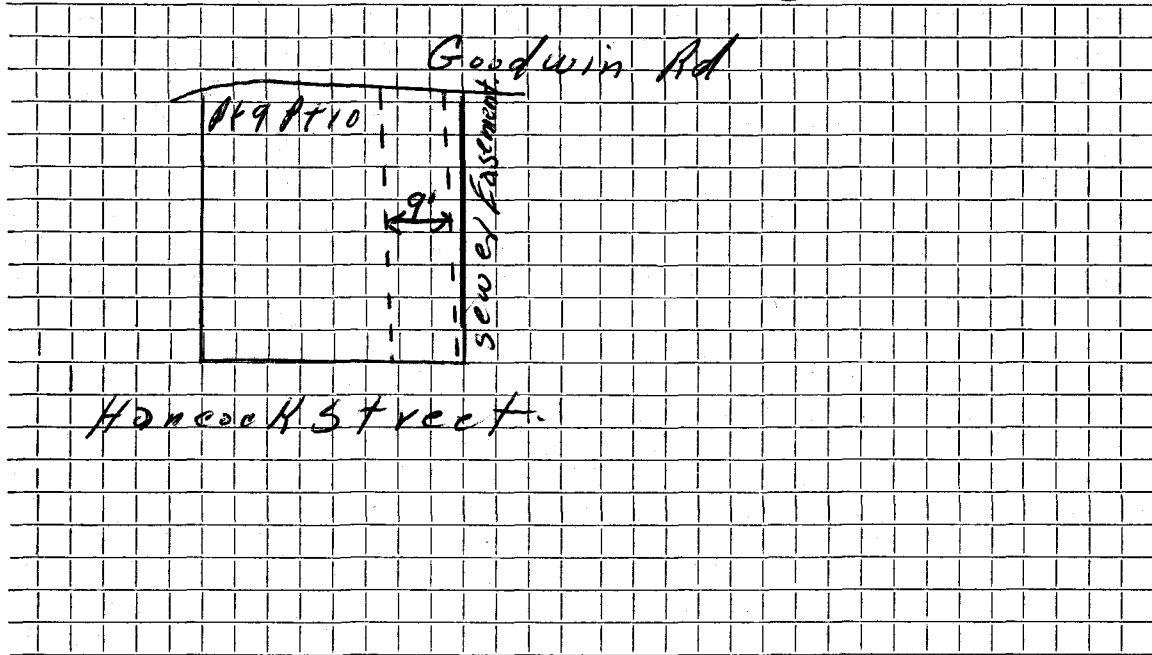

Connection made in ..... Street. Work completed .....

Remarks: *Plan D-789 - 1946* .....

.....

.....