


DATE _____

TOWN OF LEXINGTON — BOARD OF PUBLIC WORKS

SEWER DIVISION

Sketch of Service Here **10**

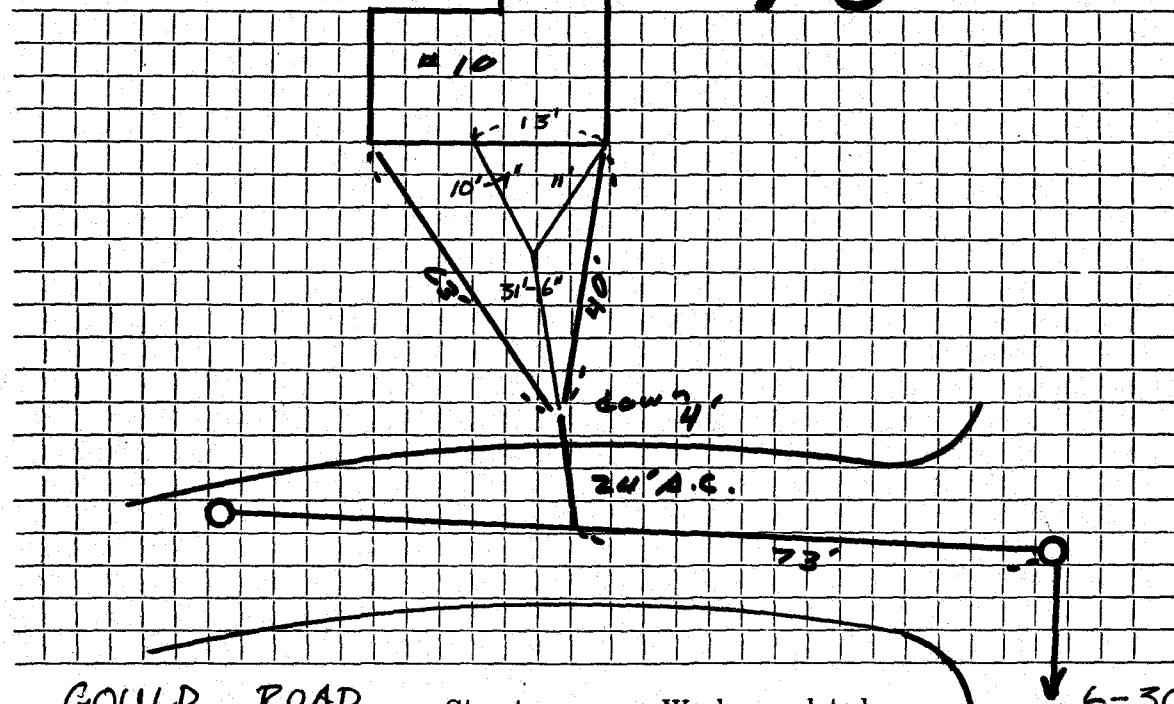

Connection made in ... GOULD ROAD Street. Work completed 6-30-75

Remarks:
.....
.....