

Name : Nocolo L. Anastasy

Service No. 107

Address 187 ~~Grove Street~~ *2 Bond Road (5-20-98)*

Location Lot #4

Kind of Pipe

Size

Size of Main

~~Repair/Replacement~~ **New Service** Brucchi #1471 W.O.#6939

Location DEC 22 1969

Date	Material	Amount	Total	Date	Amount
9/25/69	28' 6" Transite Pipe @	9.00	\$ 252 00	9-31-69	Deposit 252 00
10-2-69	26' 6" Transite pipe				
	10' 4" Cast Iron pipe				
				9-25-69	
				28' 6" Transite	


DATE _____

TOWN OF LEXINGTON — BOARD OF PUBLIC WORKS

SEWER DIVISION

Sketch of Service Here

187

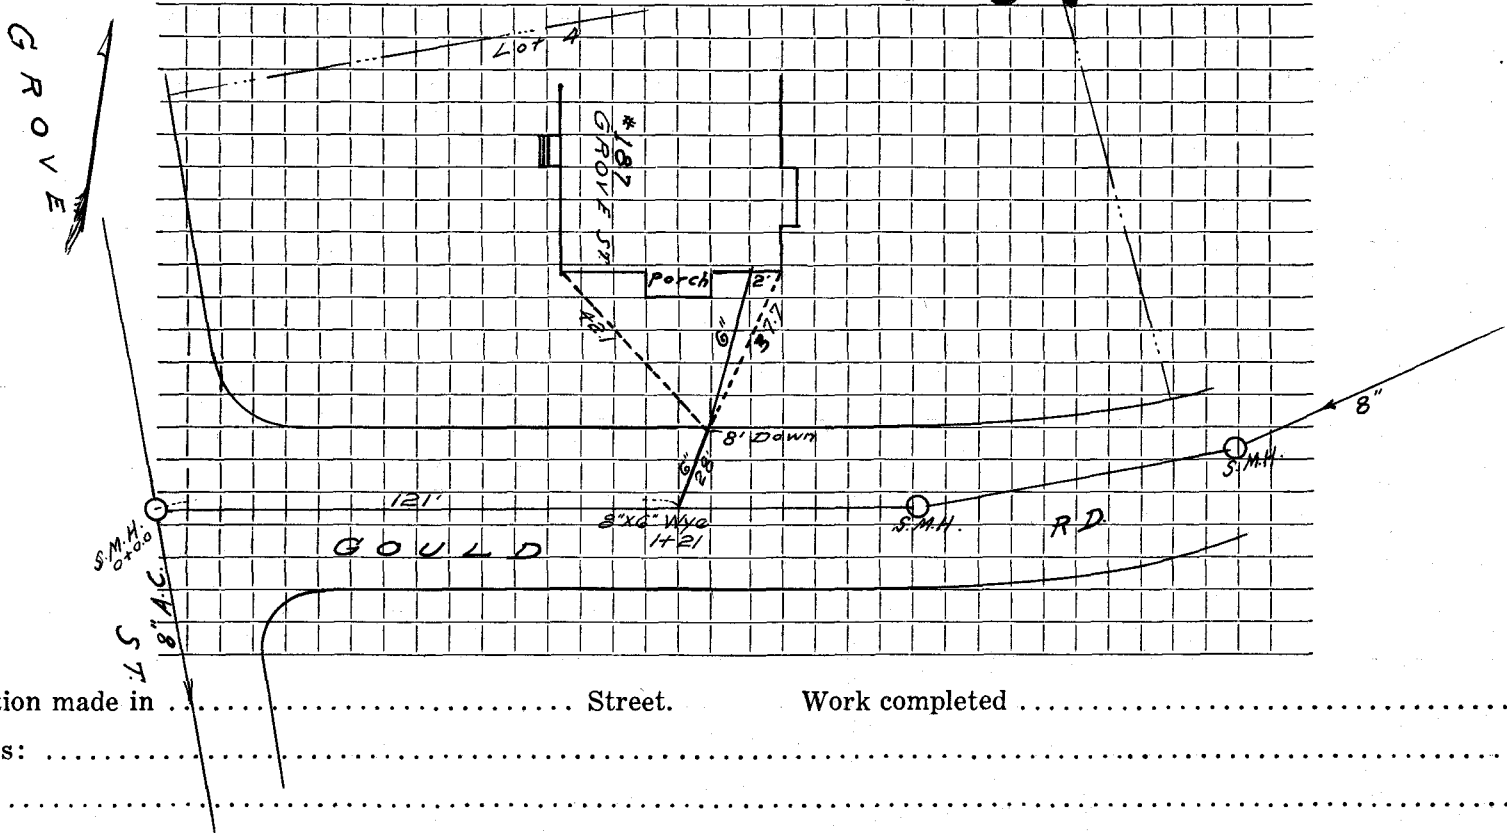

Connection made in Street. Work completed

Remarks:

.....

.....