

Name David Reiner

Service No. 175

Address 3 Gould Rd., Lexington, Mass.

Location

Kind of Pipe

Size

Size of Main

~~Repair - Renewal~~ New Service

Location Comm 12-31-61


Date	Material	Amount	Total	Date	Amount
11/30/61	Labor 86.75			11-20-61	500 00
12/1/61	" 86.75	173 50		12-31-61	96 89
	10% O.H.	17 35	190 85		403 11
	143' 6" Transite Pipe @ .78		111 54		
	6 Ton 3/4" Stone @ 1.50		9 00		
	2 22 $\frac{1}{2}$ " Transite Elbow @ 2.24		4 48		
	1 11 $\frac{1}{4}$ " Transite Elbow		2 24		
	4 Hrs. Town Shovel @ 6.50		26 00		
	2 Hrs. Trucking @ 3.00		6 00		
	2 Hrs. Loader @ 3.00		6 00		
	Spring - Loam & Seed		30 00		
	17 X 3 Patch		17 00		
			403 11		

DATE _____

TOWN OF LEXINGTON — BOARD OF PUBLIC WORKS

SEWER DIVISION

Sketch of Service Here

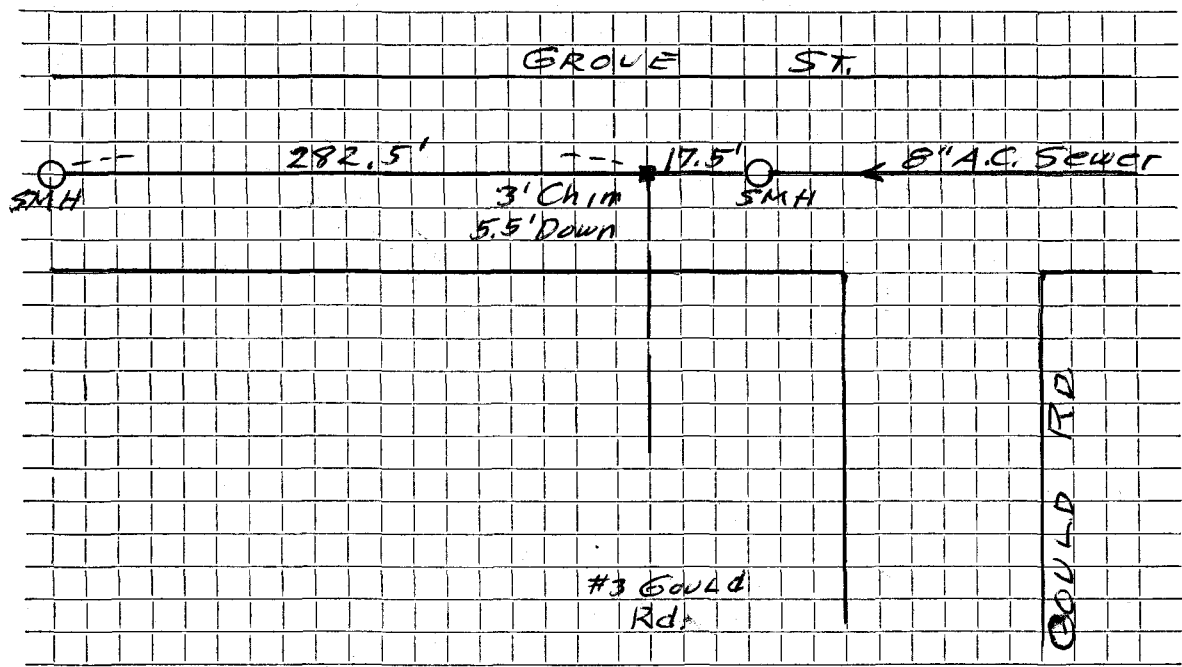

Connection made in Street. Work completed

Remarks:
.....
.....