

Name Donald H. Lyons

Service No. 92 (75)

Address 8 Gould Rd

Location

Kind of Pipe AC

Size 6"

Size of Main 8"

Repair—Renewal—New Service Valeri Const. #2749

Location AUG 16 1976

Date	Material	Amount	Total	Date	Amount
10-24-74	1' - 6" AC @	10.00 =	\$10.00	9-10-5	10 00
10/19/75	60' 6" Transite Pipe				
	12' 4" Cast Iron Pipe				
9-21-94	Repair				
	4" PVC				
	6" PVC				
	4"x4" Fernco				
	4"x6" Fernco				
	6"x6" Fernco				
	6" Clean Out				


DATE \_\_\_\_\_

TOWN OF LEXINGTON — BOARD OF PUBLIC WORKS

SEWER DIVISION

Sketch of Service Here

8

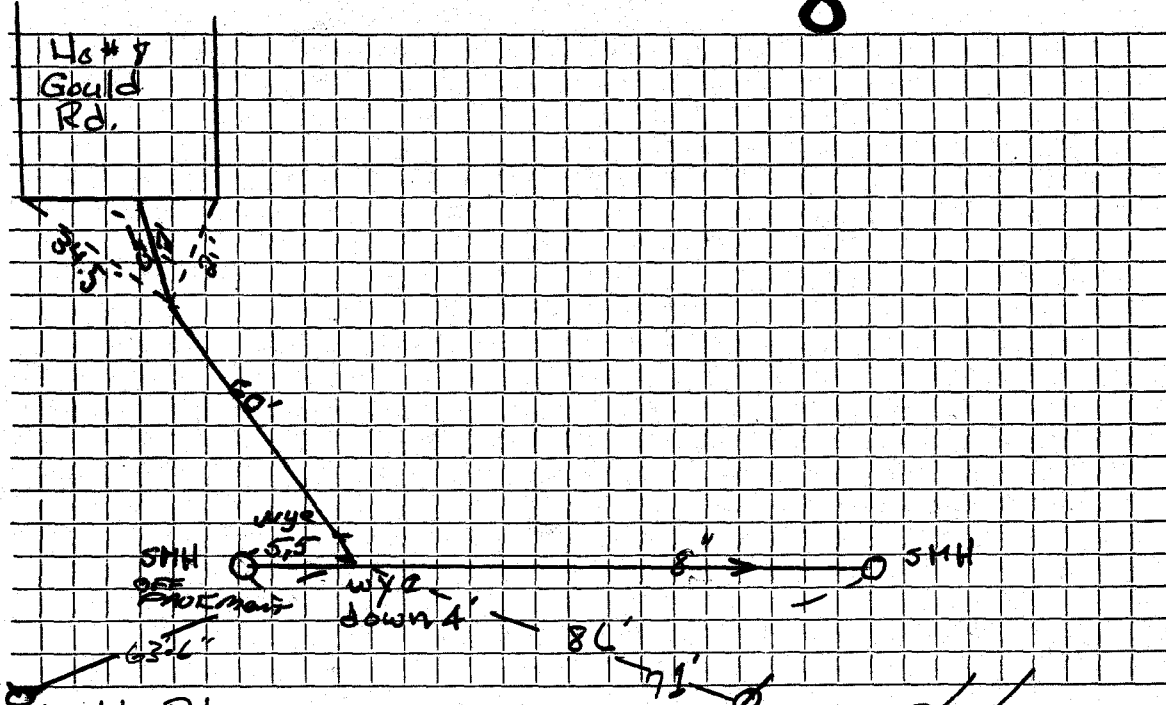

Connection made in Gould Rd. Street. Work completed 9/19/75

Remarks: man hole is off of the road about 3ft