

Name John J. Kelley

Service No. 15

Address 8 Graham Road

Location

Kind of Pipe

Size

Size of Main

~~Repair/Renewal~~ New Service

Eagle #3376

Location

MAY 21 1979

Date	Material	Amount	Total	Date	Amount
Sep 168 23'	6" Transite pipe @	8.00	184.00	4-18-79	184.00
					Deposit
				9- - 68	
4/25/79	100' 6" Transite Pipe			23'	6" Transite
	5' 4" Cast Iron Pipe				


DATE _____

TOWN OF LEXINGTON — BOARD OF PUBLIC WORKS

SEWER DIVISION

Sketch of Service Here

8

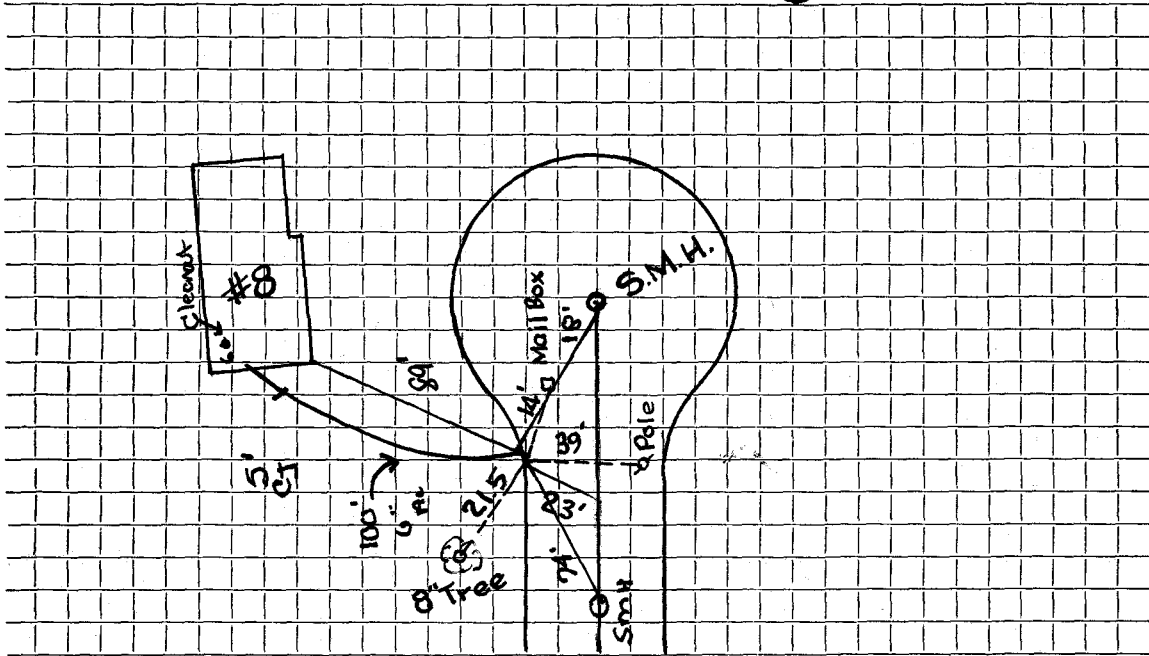

Connection made in Street. Work completed

Remarks:
.....
.....