


DATE _____

TOWN OF LEXINGTON — BOARD OF PUBLIC WORKS
SEWER DIVISION

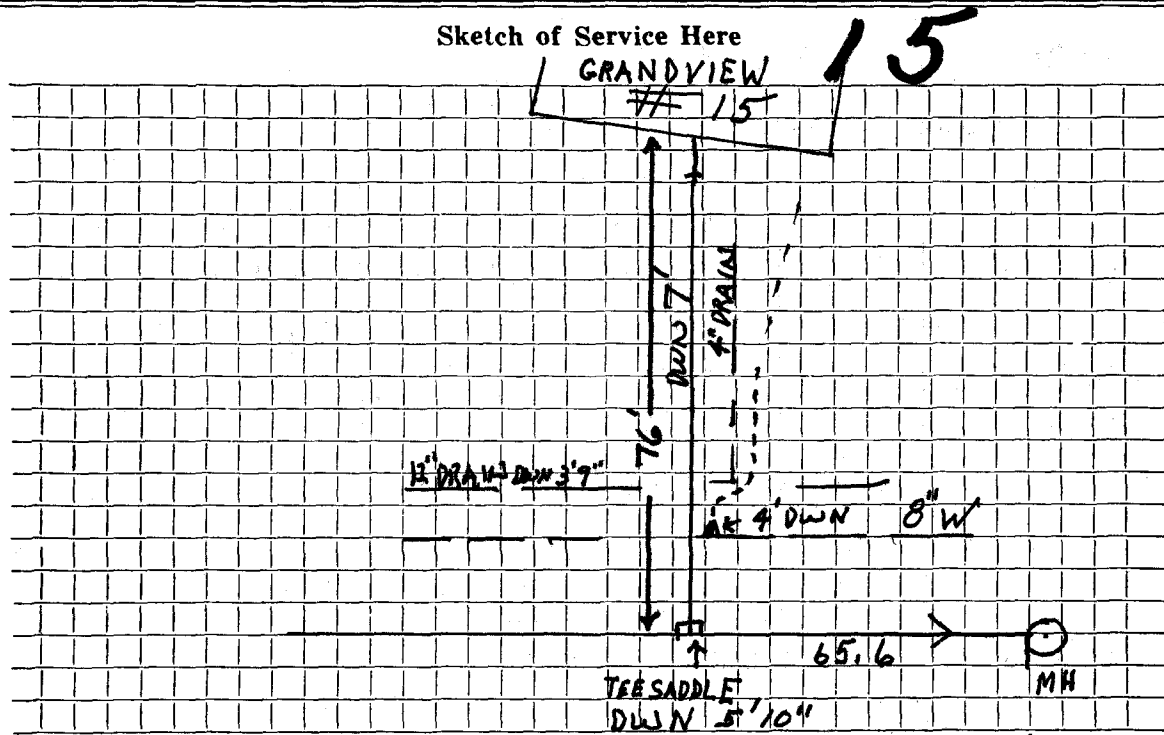

Connection made in Street. Work completed 9/6/96

Remarks: SEWER SERVICE 14" UNDER CORP. 40' MAIN