

Name Norman Newlands

Service No.

Address 49 Grandview Avenue

Lot 1

Location

Kind of Pipe

Size

Size of Main

~~Repair - Renewal~~ - New Service

Permit #266
Suburbanite Cesspool

Location


| Date | | Material | Amount | Total | Date | | Amount |
|--------|-----|------------------|--------|-------|------|--|--------|
| 5-3-65 | 80' | 6" Transite pipe | | | | | |
| | | | | | | | |
| | | | | | | | |
DATE _____

TOWN OF LEXINGTON — BOARD OF PUBLIC WORKS
SEWER DIVISION

Sketch of Service Here

49

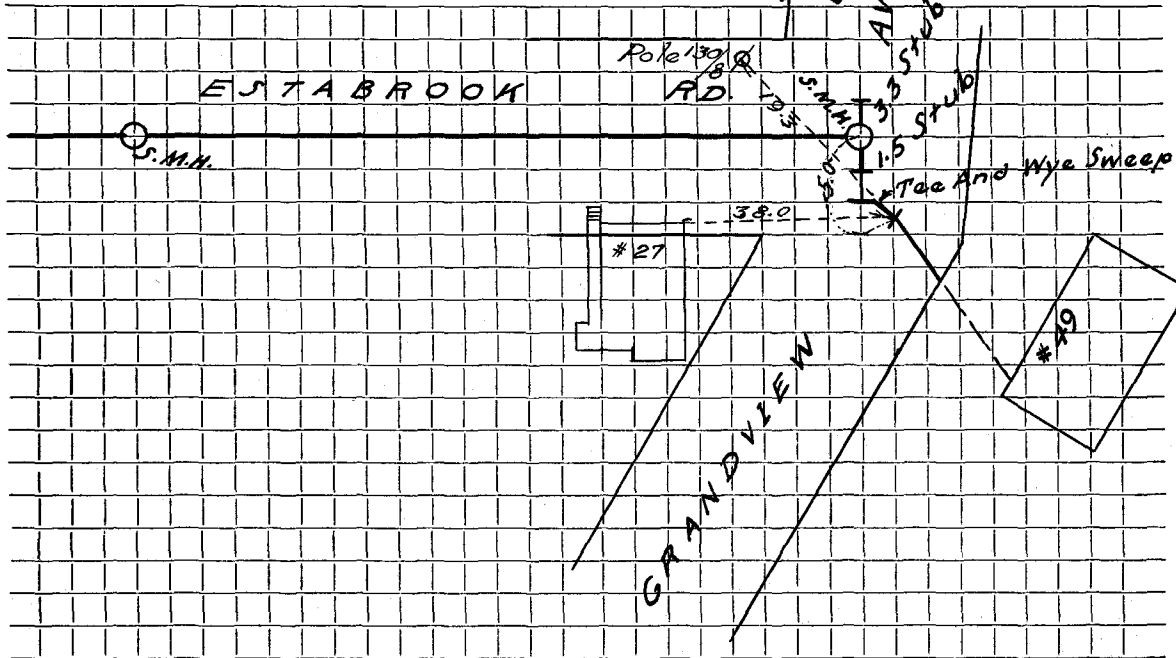

Connection made in Street. Work completed

Remarks:
.....
.....