

Name Paula Realty Trust Co.

Service No. 168

Address 8 Grandview Avenue

Location

Kind of Pipe

Size

Size of Main

~~Repair/Renewal~~ New Service WO #7681

Location *Can 1-14-63*


Date	Material	Amount	Total	Date	Amount
10-30-62	Labor	45.79			
	10% O.H.	4.58	50.37	10-22-62	Deposit 250.00
	50' 6" Transite pipe @82		41.00	1-14-63	Refund 119.54
1	6" 90° Transite Elbow		4.09		130.46
2	Hrs. Town Shovel @6.50		13.00		
2	Hrs. Trucking @3.00		6.00		
16	X 3 Patch		16.00		
			130.46		

DATE \_\_\_\_\_

TOWN OF LEXINGTON — BOARD OF PUBLIC WORKS  
SEWER DIVISION

Sketch of Service Here

8

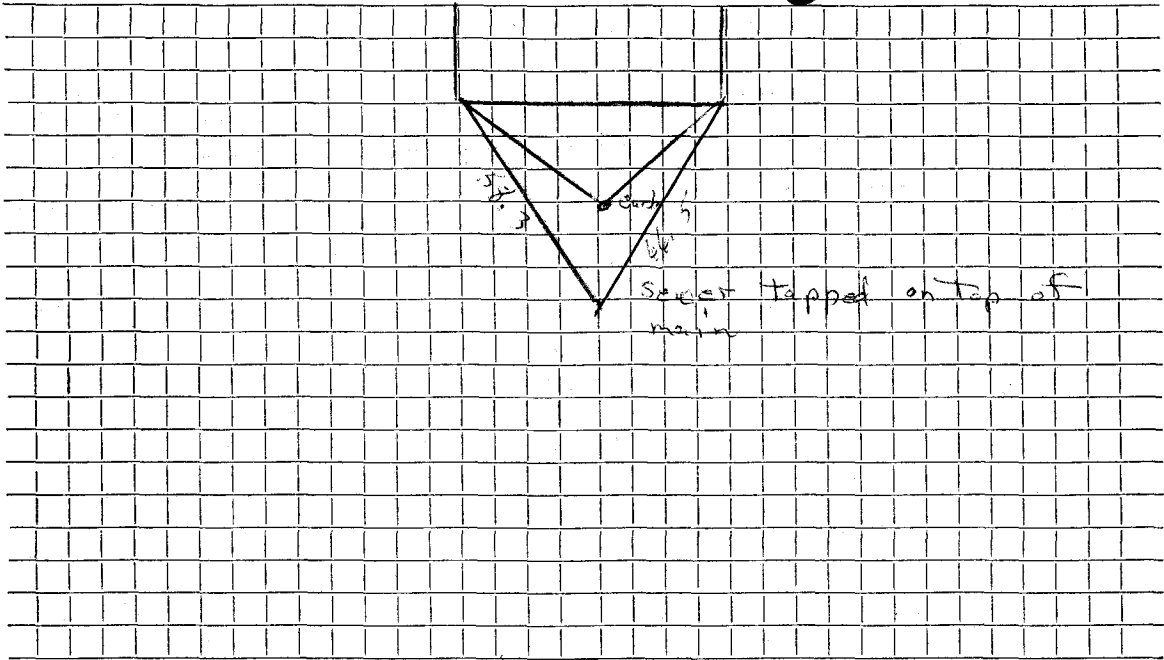

Connection made in ..... Street.                      Work completed .....

Remarks: .....  
.....  
.....