

Name

Service No.

Address

9 GRANDVIEW

Location

Kind of Pipe

Size

Size of Main

Repair—Renewal—New Service

Location

Date

Material

Amount

Total

Date

Amount

4-21-04

4x6 PVC to PVC FRANCO

10' - 4" PVC


40' - 6" PVC

6x6 PVC to Clay FRANCO

DATE _____

TOWN OF LEXINGTON — BOARD OF PUBLIC WORKS
SEWER DIVISION

Sketch of Service Here

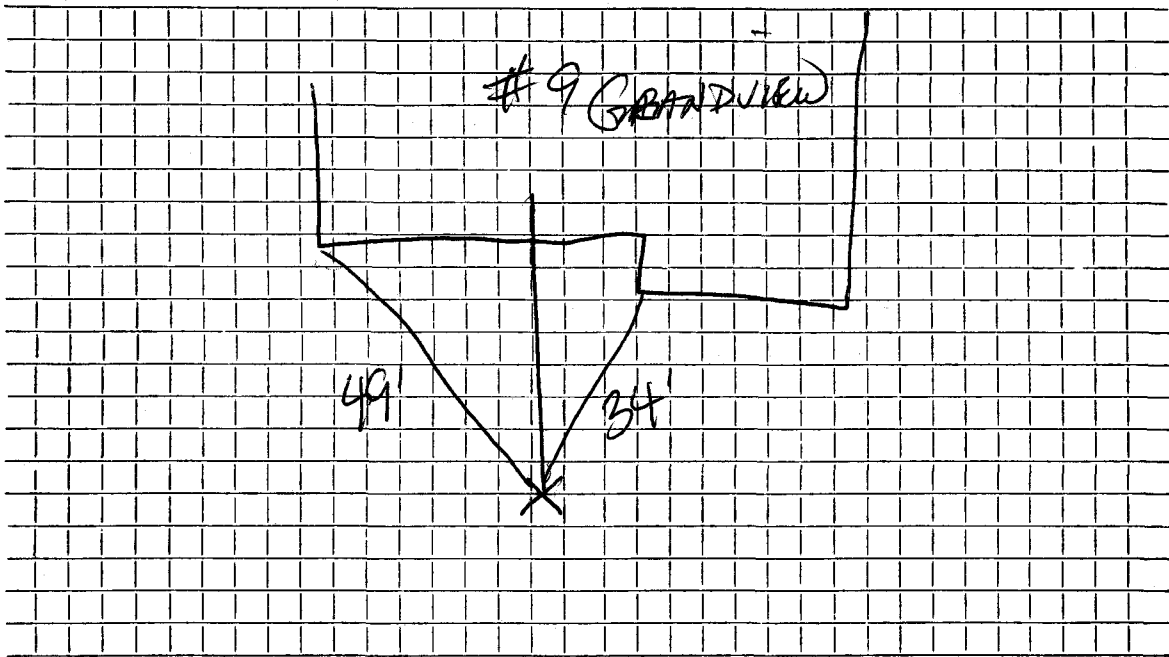

Connection made in Street. Work completed

Remarks:
.....
.....