




DATE 2 NOVEMBER 1995

TOWN OF LEXINGTON — BOARD OF PUBLIC WORKS  
SEWER DIVISION

Sketch of Service Here

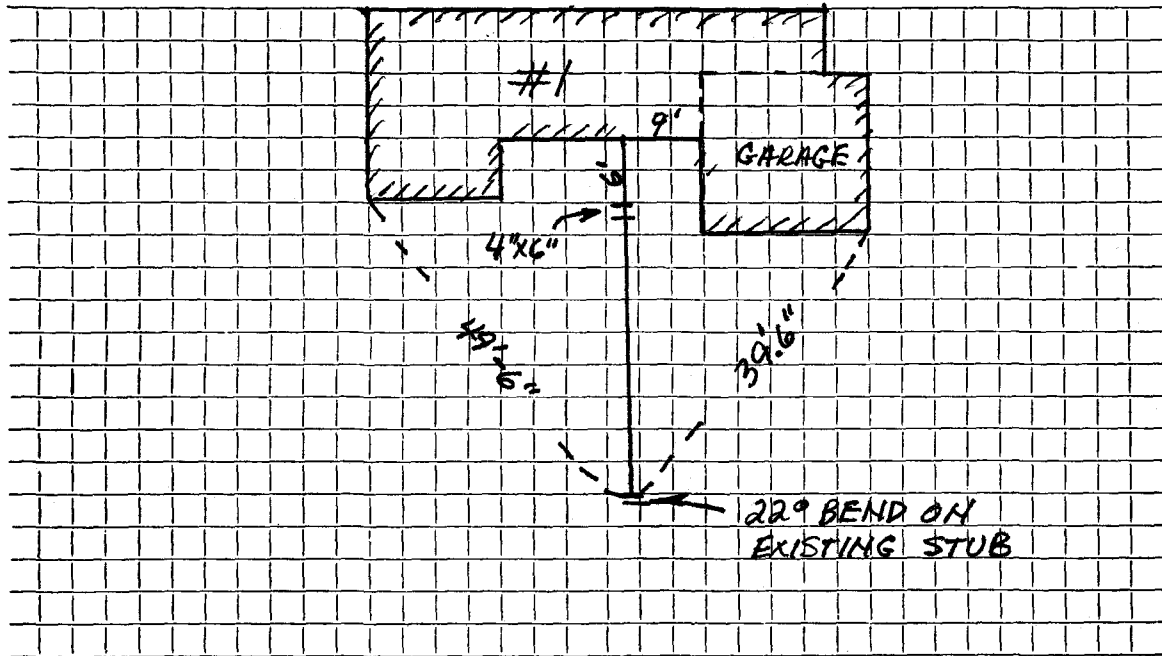

Connection made in GRANGER POND WAY Street.

Work completed J.M. McLAUGHLIN

Remarks: .....

.....

.....

BOOK 96A