


DATE 10 SEPT. 1995

TOWN OF LEXINGTON — BOARD OF PUBLIC WORKS
SEWER DIVISION

Sketch of Service Here

3

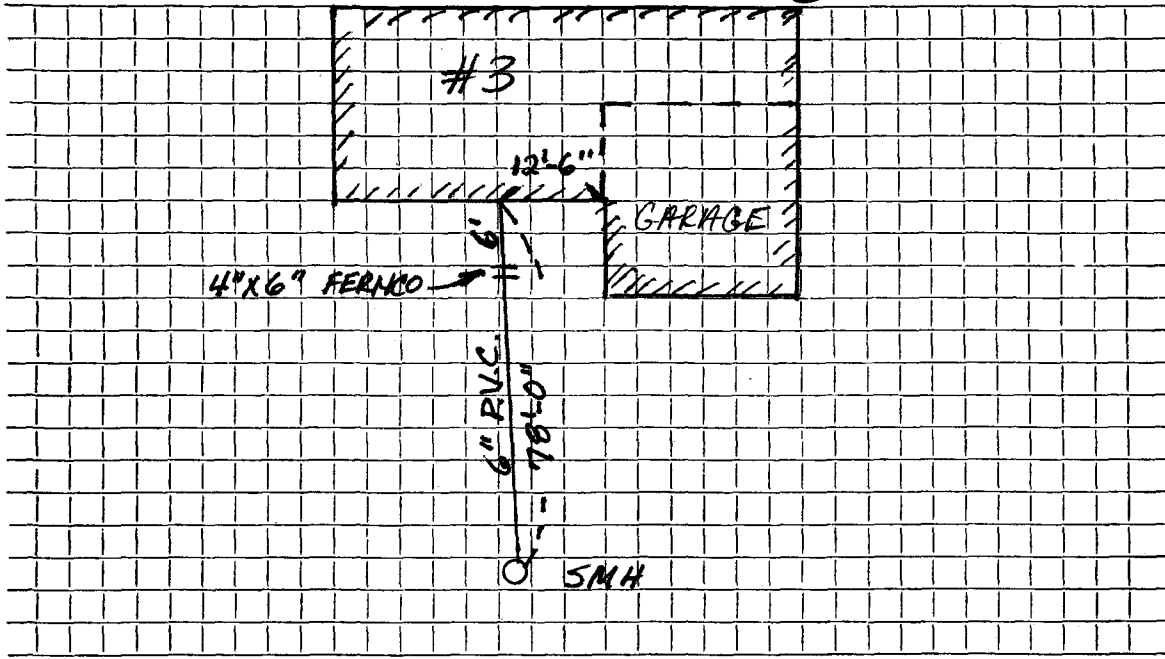

Connection made in GRANGER POND WAY Street.

Work completed J.M. McLAUGHLIN, INC.

Remarks:

.....

.....