

Name

Service No.

Address

10 GRANT ~~SE~~ PL.

Location

Kind of Pipe

Size

Size of Main

Repair—Renewal—New Service

Location

Date

Material

Amount

Total

Date

Amount


8-1-08

4" TY AT CLEANOUT
90° LONG SWEEP LEAD
4" PLASTIC PIPE

DATE 08-01-08

TOWN OF LEXINGTON — BOARD OF PUBLIC WORKS
SEWER DIVISION

Sketch of Service Here

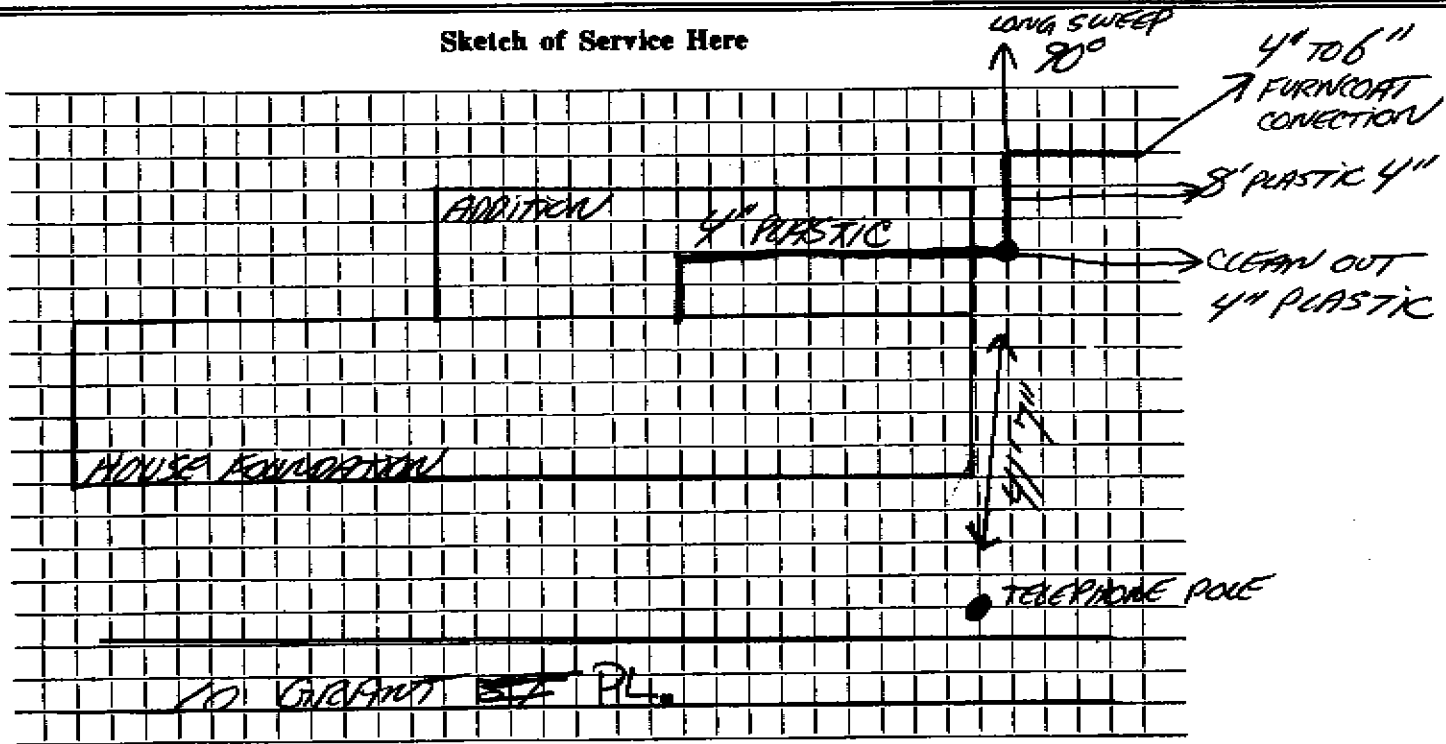

Connection made in Street. Work completed

Remarks: