


DATE _____

TOWN OF LEXINGTON — BOARD OF PUBLIC WORKS

SEWER DIVISION

Sketch of Service Here

6" x 6" wye
clean out
450 Bend

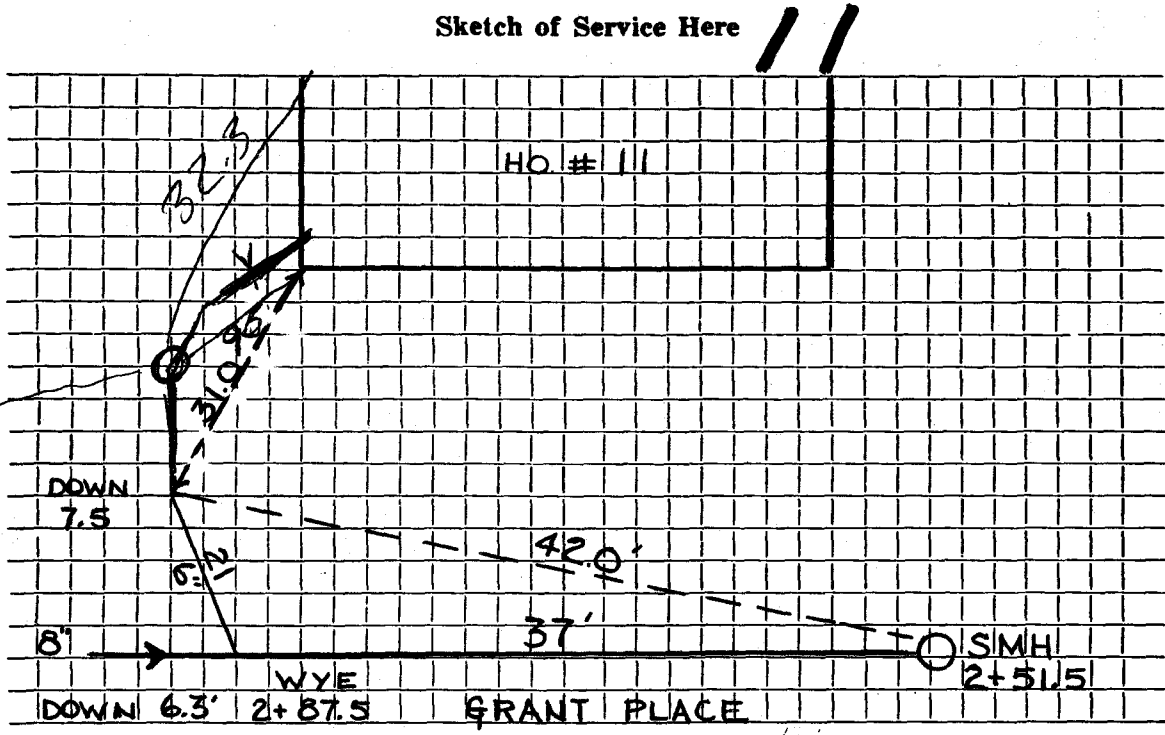

Connection made in . GRANT PLACE Street. Work completed

Remarks: