


DATE _____

TOWN OF LEXINGTON — BOARD OF PUBLIC WORKS
SEWER DIVISION

Sketch of Service Here **18**

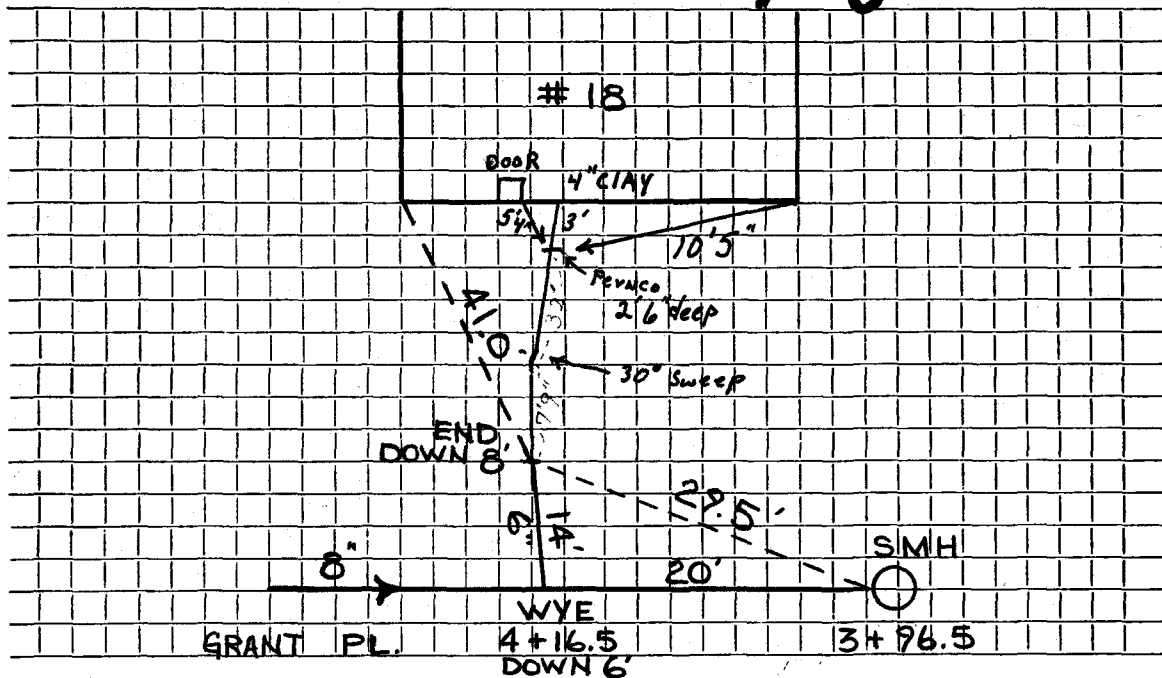

Connection made in ..GRANT..PLACE..... Street. Work completed

Remarks:
.....
.....