

Name

Service No.

Address

90 Grant

Location

Kind of Pipe

SDR35

Size

6"

Size of Main

Repair—Renewal—New Service

Location

Date

Material

Amount

Total

Date

Amount

6/2017 - 6" SDR ~100

" - CLEAN OUT 6"
6" SDR PIPER
6" PVC CAP
6" TEE W/4" PVC

" - 6" PVC 45° BEND 1


- 6"x6" FURNISHED
PVC → AC 1

DATE 6/2017

TOWN OF LEXINGTON — BOARD OF PUBLIC WORKS

SEWER DIVISION

Sketch of Service Here

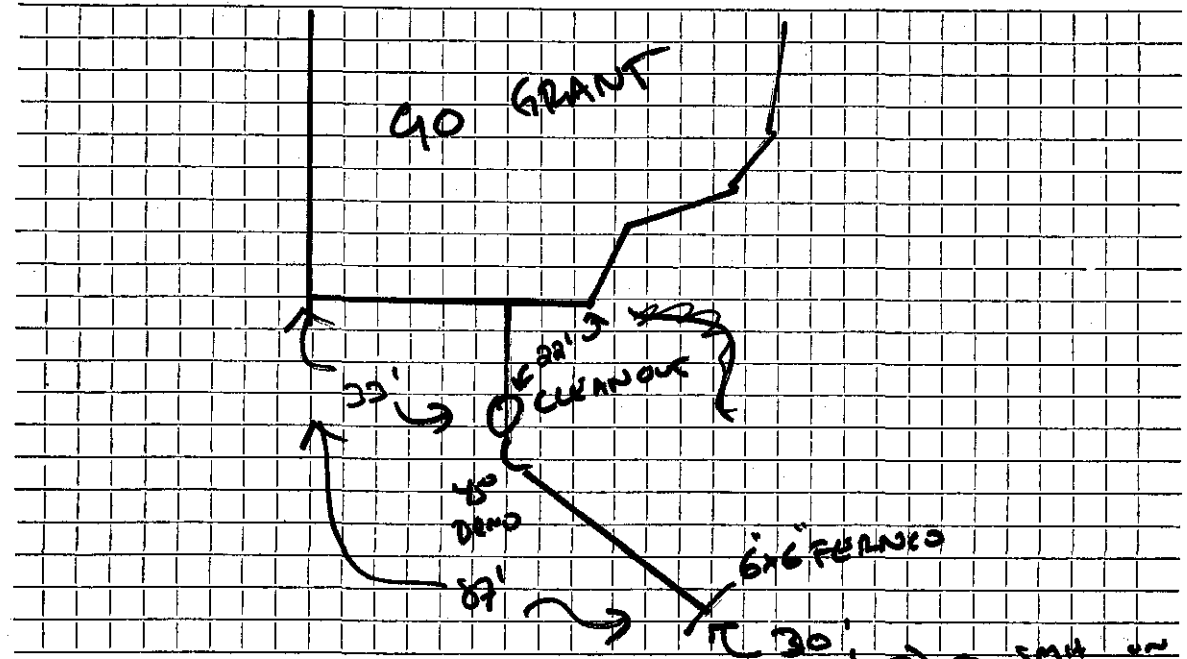

Connection made in GRANT Street. Work completed SMITH GRANT

Remarks: HANKINS