

Name

Service No.

Address

111 GRANT ST.

Location

Kind of Pipe

ACP

Size 6"

Size of Main 8"

Repair—Renewal—New Service

Location

Date

Material

Amount

Total

Date

Amount

~~6/17/80~~

~~22' of 6" ACP @ \$14.00/ft~~

~~\$308.00~~

6-17-80

6-21-99

Inside installed

22' 6" A.C.P.

4' - 4" PVC

35' - 6" PVC

6x6x4 wye cleanout

6x4 PVC to PVC Franco

6x4 PVC to AC Franco


DATE \_\_\_\_\_

TOWN OF LEXINGTON — BOARD OF PUBLIC WORKS

SEWER DIVISION

Sketch of Service Here

111

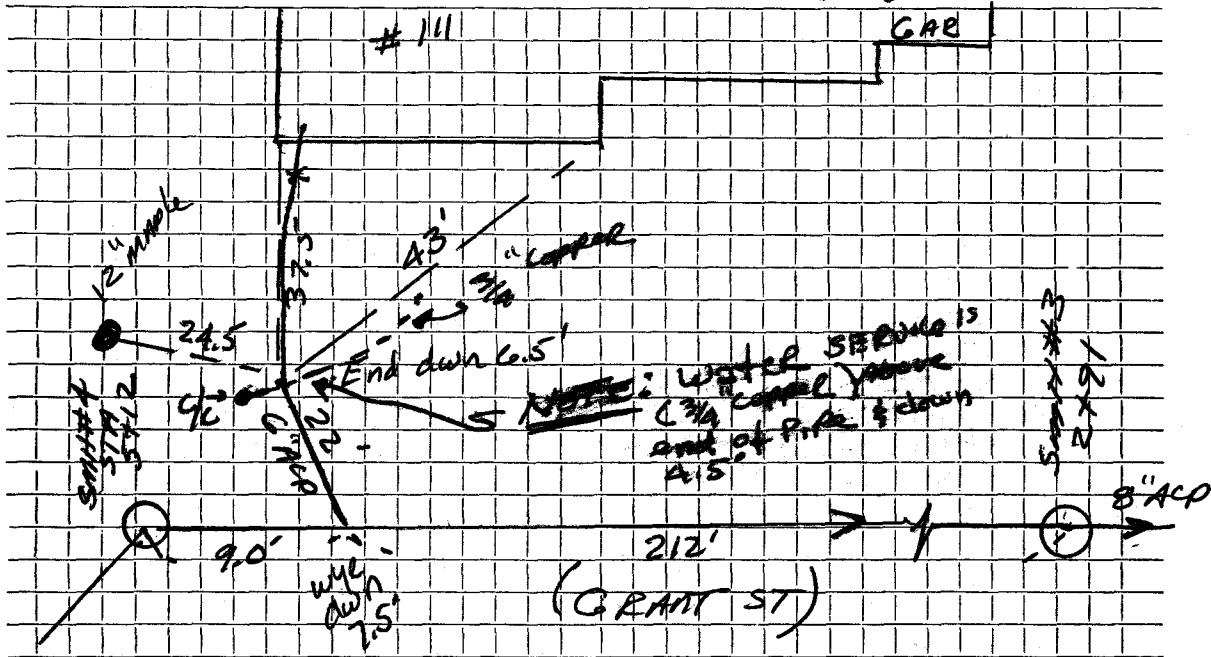

Connection made in ..... GRANT ..... Street. Work completed .....

Remarks: .....