


DATE _____

TOWN OF LEXINGTON — BOARD OF PUBLIC WORKS

SEWER DIVISION

Sketch of Service Here

112

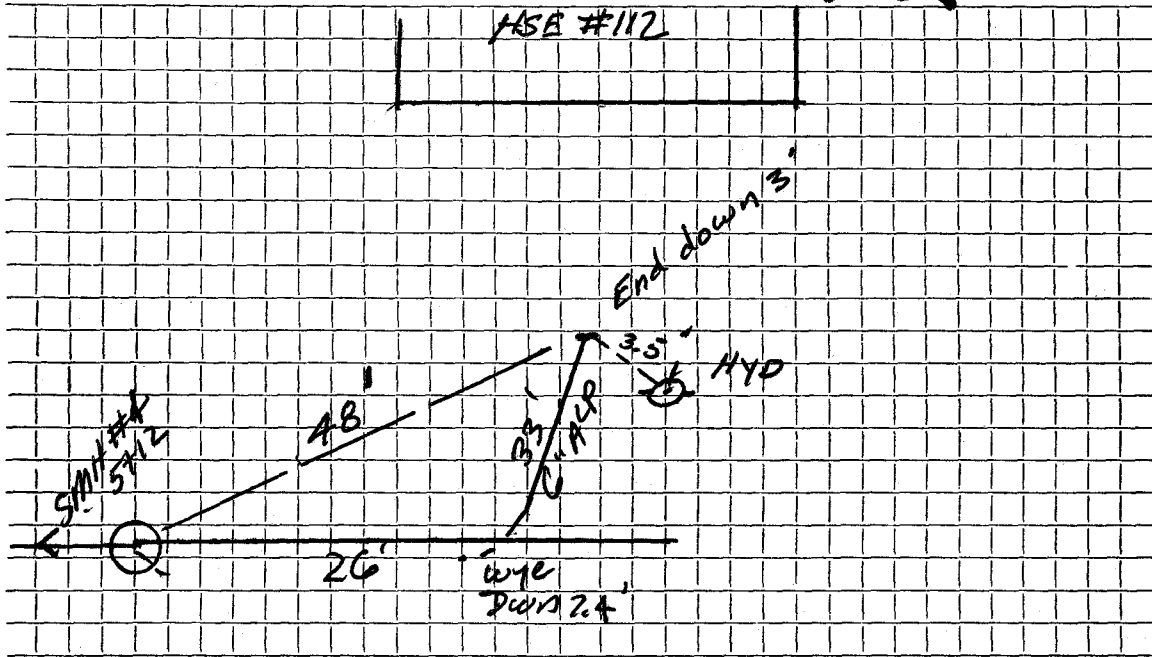


Connection made in Street. Work completed

Remarks:
.....
.....

DATE JAN 14 1998

TOWN OF LEXINGTON — BOARD OF PUBLIC WORKS
SEWER DIVISION

Sketch of Service Here

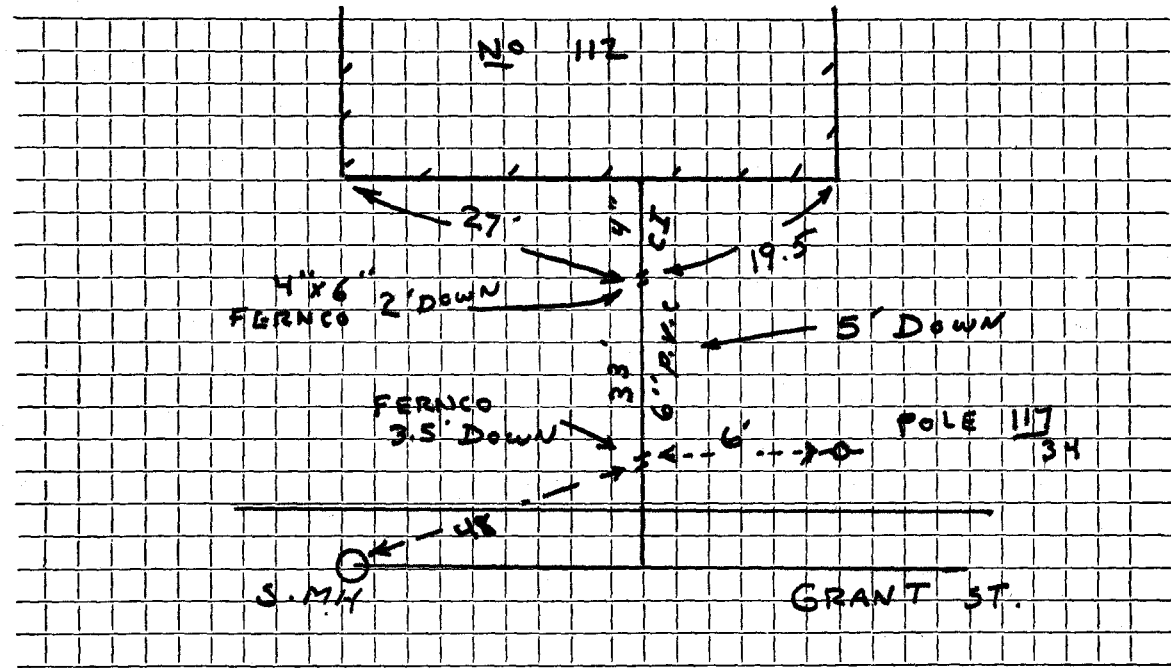

Connection made in GRANT Street. Work completed by J.M. McLaughlin

Remarks:

.....
.....
..... FIELD BOOK 97-5 TJM