

Name

Service No.

Address

115 GRANT ST

Location

Kind of Pipe

ACP

Size

6"

Size of Main

8"

Repair—Renewal—New Service

Location

Date

Material

Amount

Total

Date

Amount

~~6-19-80~~ 25' of 6" ACP @ \$14.00/A = \$350.00

3-16-00 82.6-6" PVC
1-22° Bend
1-6x6x4 Wye
1-6" AC-PVC Ferroc


6-19-80
25' 6" A.C.P.

DATE _____

TOWN OF LEXINGTON — BOARD OF PUBLIC WORKS
SEWER DIVISION

Sketch of Service Here

115

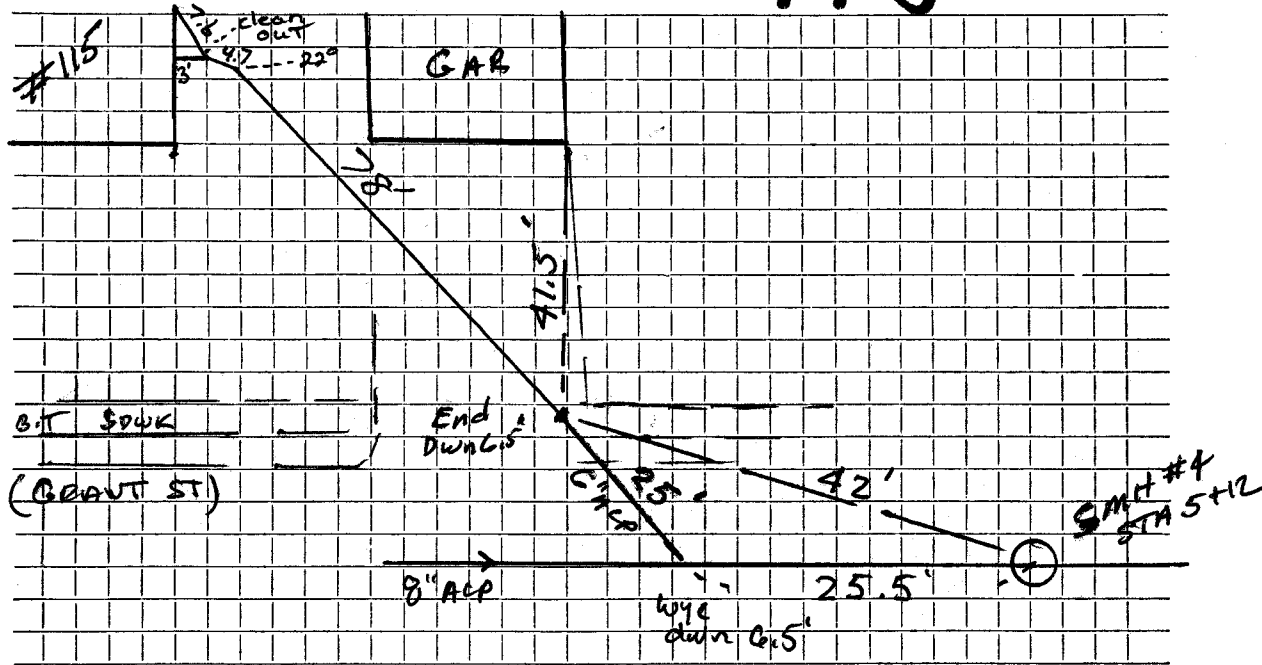

Connection made in Grant Street. Work completed

Remarks: Clean out 3' From Foundation