

Name Ansel S. Davis

Service No. 34

Address #119 Grant st.

Location

Kind of Pipe ACP

Size 6"

Size of Main 8" ACP

~~Repair - Renewal~~ New Service

Valeri #4984


Location

Date	Material	Amount	Total	Date	Amount
6/25/80	36' of 6" ACP @ \$14.00/A =	504.00	504.00	7-27-81	Deposit 504.00
10/1/87	31' 6" 6" PVC				
	8' 4" Cast			6-25-80	
	2 22° Bends			36' 6" A.C.P.	
	AC to PVC Fernco				
	1 4" x 6" Fernco				

DATE _____

TOWN OF LEXINGTON — BOARD OF PUBLIC WORKS
SEWER DIVISION

Sketch of Service Here **119**

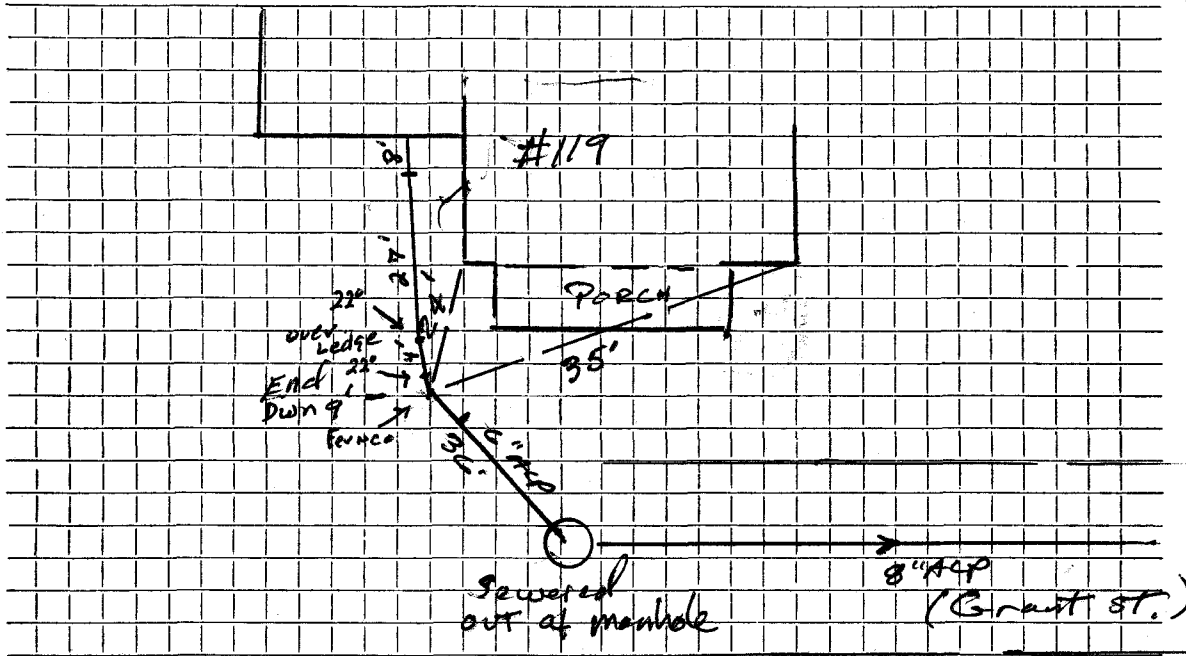

Connection made in Grant Street. Work completed

Remarks:
.....
.....