

Name Lewis Gurman

Service No. 11

Address #122 Grant St.

Location

Kind of Pipe ACP

Size 6"

Size of Main 4ep

~~Repair~~ ~~Renewal~~ New Service Valeri #4358


Location

Date	Material	Amount	Total	Date	Amount
6/26/80	35' of 6" ACP @ 14.00 / ft =	490.00	\$ 490.00	1-6-87	Deposit 490.00
1/12/87	61' 6" P.V.C.			6-26-80	
	1 4" x 6" Fernco from iron to PVC			35' 6" A.C.P.	
	1 22° Sweep PVC				
	1 Wye PVC for clean out				
	1 6" Fernco from PVC to Transite				

DATE _____

TOWN OF LEXINGTON — BOARD OF PUBLIC WORKS
SEWER DIVISION

Sketch of Service Here **122**

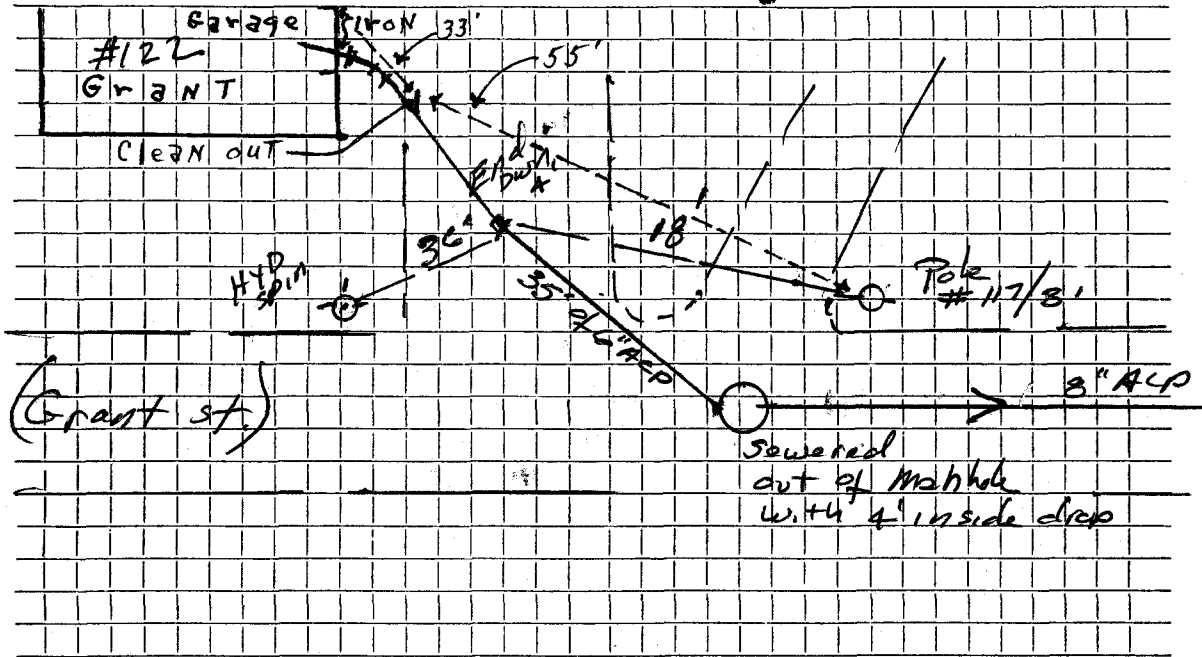

Connection made in Grant Street. Work completed

Remarks: