

Name

Service No.

Address

123 Grant St

Location

Kind of Pipe

Size

Size of Main

Repair—Renewal—New Service

Arlex

Location Lot 42

Date

Material

Amount

Total

Date

Amount

6/23/09

?

4" PVC

6" PVC

1

Clear out

1

6" Ferroco

5/19/62

1

8X6-Tee

Arlex Pipe


1

22° bend

DATE _____

TOWN OF LEXINGTON — BOARD OF PUBLIC WORKS
SEWER DIVISION

Sketch of Service Here

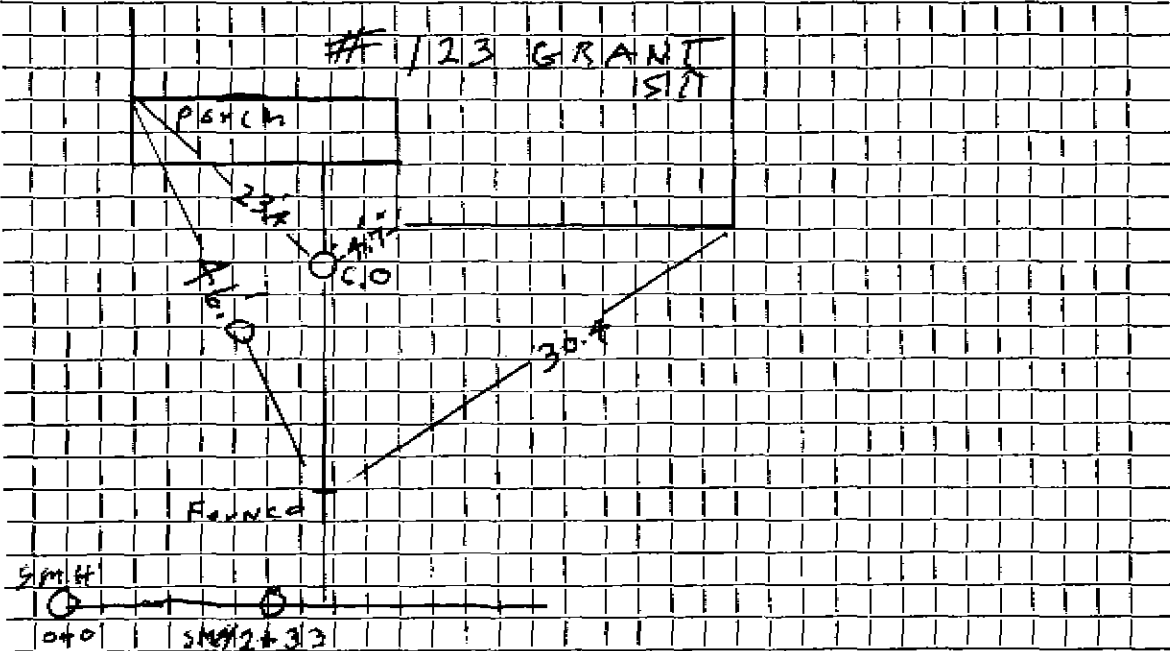

Connection made in Street.

Work completed 6/23/09 Auler.....

Remarks: No. of.....
.....
.....