


DATE 7/12/95

TOWN OF LEXINGTON — BOARD OF PUBLIC WORKS
SEWER DIVISION

Sketch of Service Here **126**

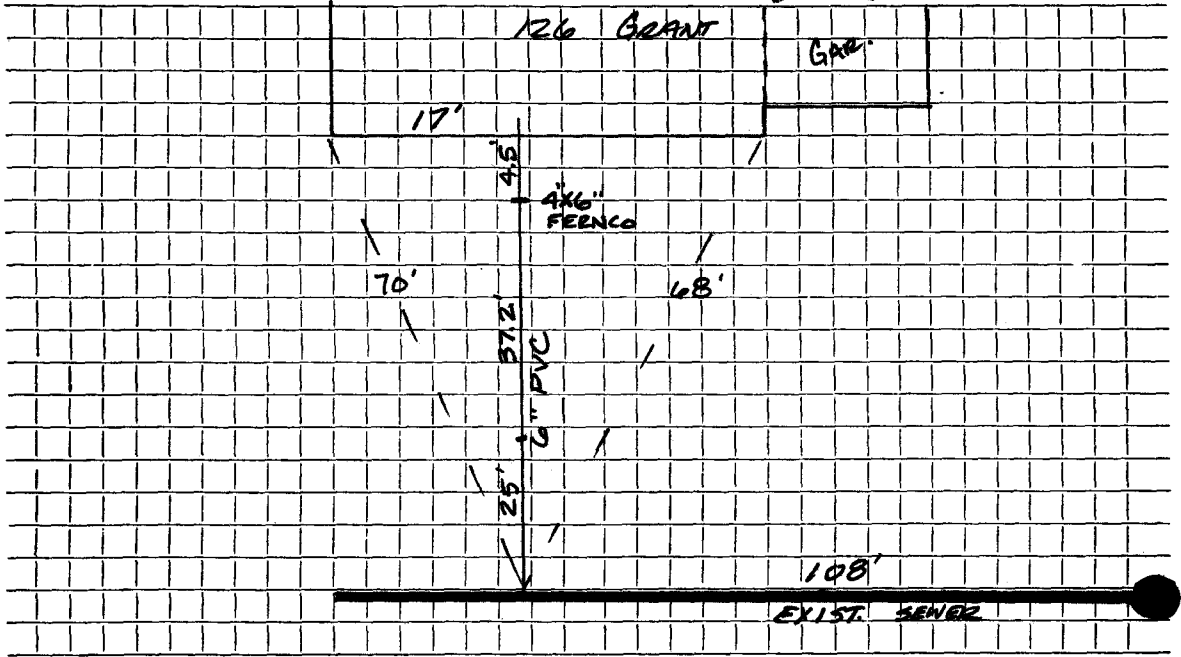

Connection made in GRANT Street. Work completed ... ROCKWELL CONSTRUCTION

Remarks:
.....
.....