

Name Thomas Travers

Service No. 239

Address 136-138 Grant Street

Location

Kind of Pipe

Size

Size of Main

~~Water General~~ — New Service


Location Comm 12-31-60

Date	Material	Amount	Total	Date	Amount
11-22-60	Labor	37.72		11-26-60	Deposit 250.00
11-23-60	"	44.00	81.72	12-31-60	Retuned 52.43
	10% O.H.	8.17	89.89		197.57
	50' 6" Transite pipe @.78		39.00		
	7 3/4 ton Bank Gravel @85		6.58		
	1 90° Transite Elbow		5.40		
	2 11 1/2° Transite Bands @5.10		10.20		
	3 hrs. Town Shovel @6.50		19.50		
	3 hrs. Trucking @3.00		9.00		
	1 hr. Trailer @3.00		3.00		
	15 x 3 Patch		15.00		
			197.57		

DATE \_\_\_\_\_

TOWN OF LEXINGTON — BOARD OF PUBLIC WORKS  
SEWER DIVISION

Sketch of Service Here

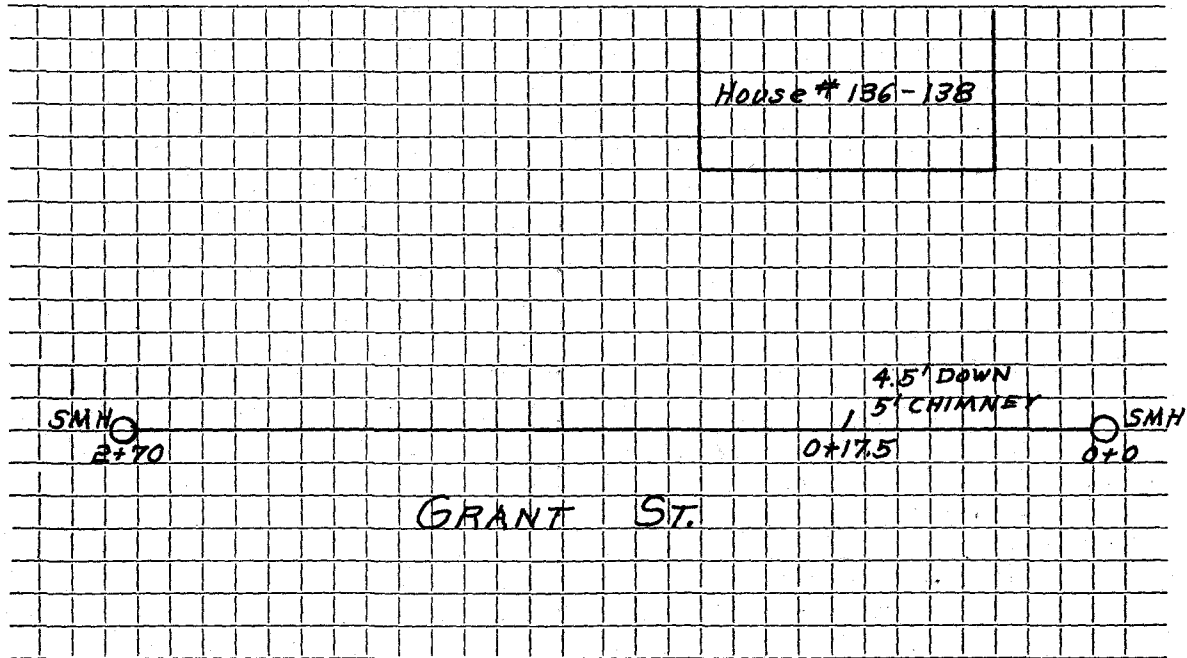

Connection made in ..... Street. Work completed .....

Remarks: .....  
.....  
.....