
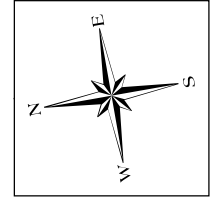


**Sewer Service Tie Card**  
**TOWN OF LEXINGTON**  
 MASSACHUSETTS

**137 Grant Street**

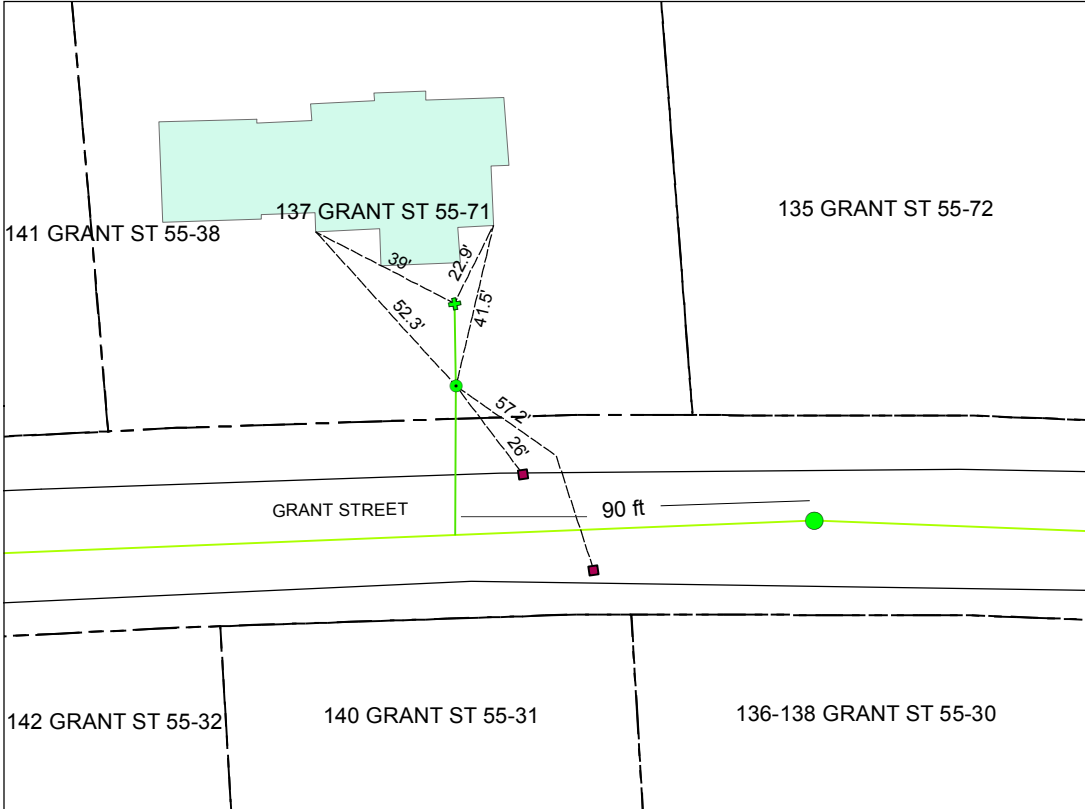

Legend	
<span style="color: green;">●</span>	Sewer Manholes
<span style="color: green;">+</span>	Sewer Service Clean Out
<span style="color: green;">●</span>	Sewer Service Connection
---	Ties_Dimensions Sewer
—	Sewer Service Line
<span style="color: red;">■</span>	Catch Basin

Address	Map and Lot	Permit Number	Contractor Name	Inspector
137 Grant Street	55-71	5373	H. Rice & Sons	dpavlik

Date: 10/3/2013	Material	Depth of Cover	Amount
	6x6 AC to PVC Fern Co	6.5 ft	Connected to existing stub
	6" PVC	6.2 ft	20 Feet to C.O.
	6"x4" Fern Co.	6 ft	Fern Co. at Clean Out

Type of work completed

**New 6" PVC sewer service installed from old sewer connection. New house built old house removed.**