

Name Joseph A. Busa

Service No. 224

Address 140 Grant Street

Location

Kind of Pipe

Size

Size of Main

~~Renewal~~ New ServiceLocation *Comm 12-12-60*


Date	Material	Amount	Total	Date	Amount
10-25-60	Labor	67.55		<i>10-18-60</i>	<i>Deposit</i> 200.00
11-19-60	Labor	7.89		<i>12-12-60</i>	<i>Retained</i> 36.44
		<u>75.44</u>			<u>163.96</u>
	10% O.H.	7.54	82.98		
	45' 6" Transite Pipe @.78		35.10		
	2 11 1/2° Transite Elbows @2.24		4.48		
	1 6" 90° Transite Elbow		5.40		
	2 hrs. Town Shovel @6.50		13.00		
	2 hrs. Trucking @3.00		6.00		
	1 hr. Loader @3.00		3.00		
	14 X 3 Patch		<u>14.00</u>		
			163.96		
				<i>1-12-74</i>	<i>Plugged Sewer</i>

DATE \_\_\_\_\_

TOWN OF LEXINGTON — BOARD OF PUBLIC WORKS

SEWER DIVISION

Sketch of Service Here

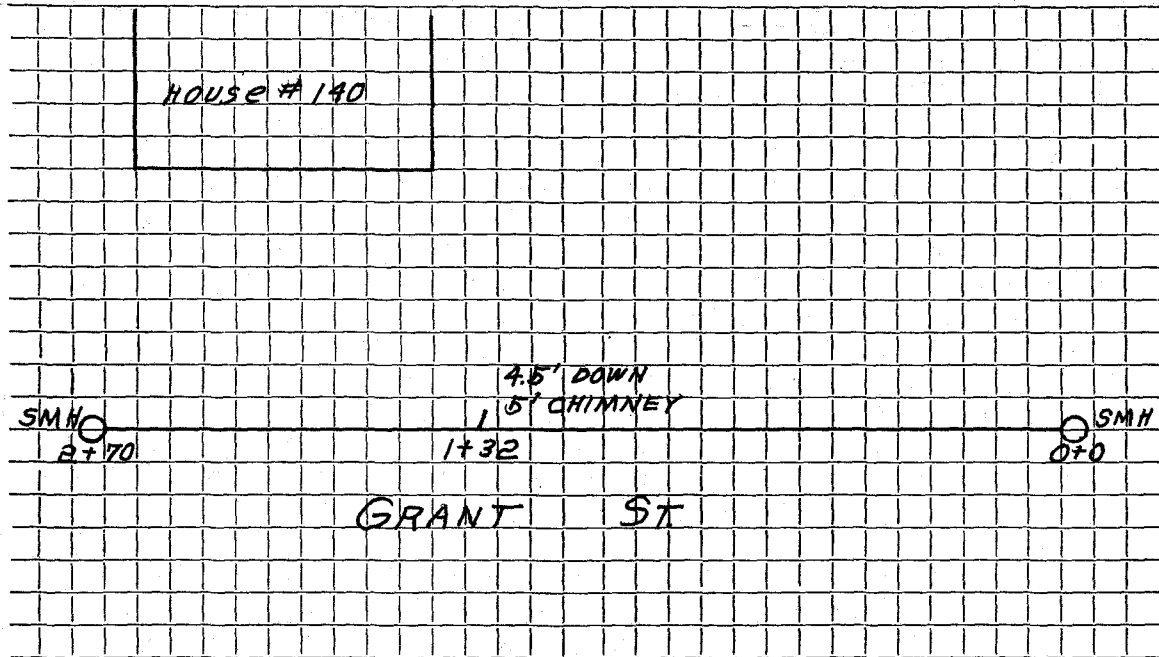

Connection made in ..... Street. Work completed .....

Remarks: .....  
.....  
.....