


DATE 11/14/89

TOWN OF LEXINGTON — BOARD OF PUBLIC WORKS
SEWER DIVISION

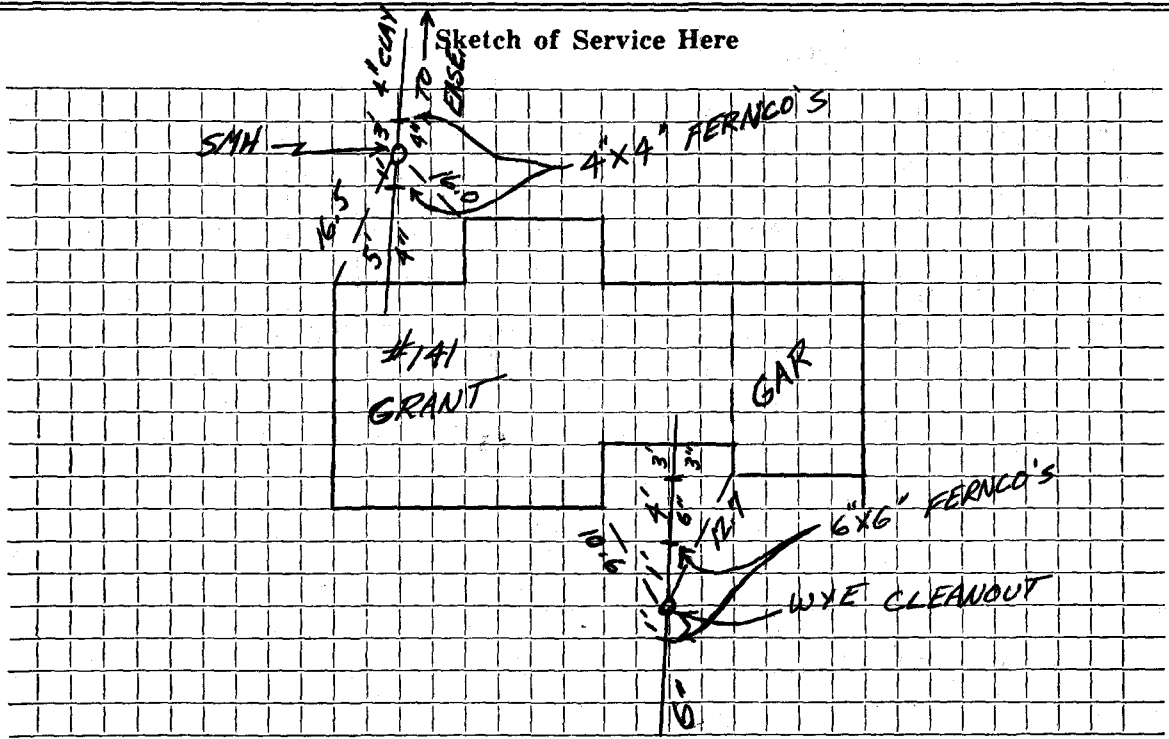

Connection made in Street. Work completed

Remarks: INSP. CRG

Name ~~Angelo~~ ~~Chan~~ *Sam Chan* 761-1997

Service No. 240

Address 141 Grant Street

Location

Kind of Pipe

Size

Size of Main

~~RENEWAL~~ New Service


Location *Penn 12-31-60*

Date	Material	Amount	Total	Date	Amount	
11-23-60	Labor	28.88		10-26-60	Deposit	400.00
11-25-60	"	79.38		1-19-61	Paid	37.87
11-26-60	"	7.41				437.87
11-28-60	"	64.03	179.70		NON CHARGE	
	10% O.H.	17.97	197.67	11-26-60	Labor	7.41
	149' 6" Transite pipe @.78		116.22			
	12 ton 3/4" Stone @1.50		18.00			
	1 22 ¹ / ₂ " Transite Elbow		2.24			
	1 11 ¹ / ₂ " Transite Elbow		2.24			
	1 11 ¹ / ₂ " Transite Bend		5.10			
	1 90° Transite Elbow		5.40			
	6 hrs. Towm Shovel @6.50		39.00			
	4 hrs. Trucking @3.00		12.00			
	40 x 3 Patch		40.00			
			437.87			
				12-31-60	Bill sent	37.87

DATE _____

TOWN OF LEXINGTON — BOARD OF PUBLIC WORKS
SEWER DIVISION

Sketch of Service Here

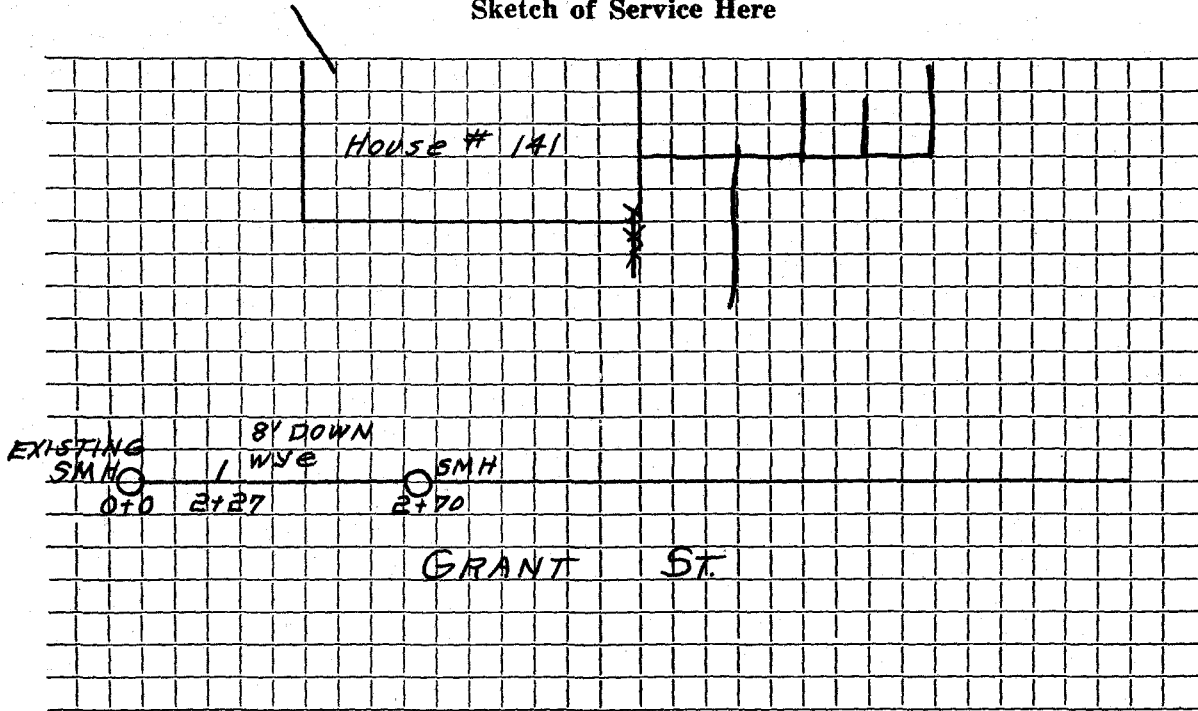

Connection made in Street. Work completed

Remarks:
.....
.....