




DATE 1/3/22

TOWN OF LEXINGTON — BOARD OF PUBLIC WORKS  
SEWER DIVISION

Sketch of Service Here

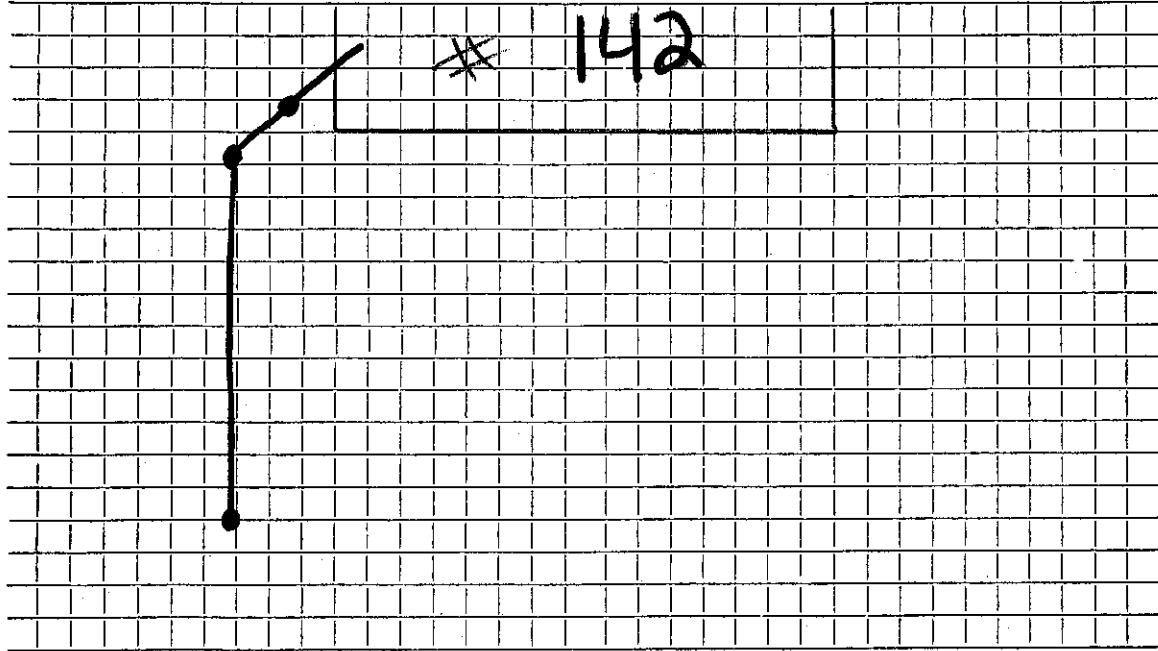

Connection made in Grant St Street. Work completed .....

Remarks: .....

.....