

Name Francis De Roche

Service No. 25

Address 144 Grant Street

Location

Kind of Pipe

Size

Size of Main

Repair—Renewal—New Service

Valeri #573 W.O. # 4425

Location

JUL 24 1967

Date	Material	Amount	Total	Date		Amount
5/9/67	Labor	67.24		4-26-67	Deposit	125.00
	10% O.H.	6.72	73.96	8-8-67	Paid	2.39
23'	6" Sewer Pipe @.88		20.24			137.39
1	90' Transite Elbow		4.09	5-9-67		
1	Ton Hot Top		5.50		23' 6" Sewer Pipe	
3	hr. Trucking @3.00		9.00		1 6"-90° Elbow Transite	
1/2	hr. Roller		1.50			
2	hr. Back hoe @6.50		13.00			
			127.29			
5/22/66	6" Transite					
12-9-93	36' 6" PVC					
	5' 4" CAST					
1	6" X 4" FERNCO					
1	6"-22° Bend					


DATE _____

TOWN OF LEXINGTON — BOARD OF PUBLIC WORKS

SEWER DIVISION

Sketch of Service Here

144

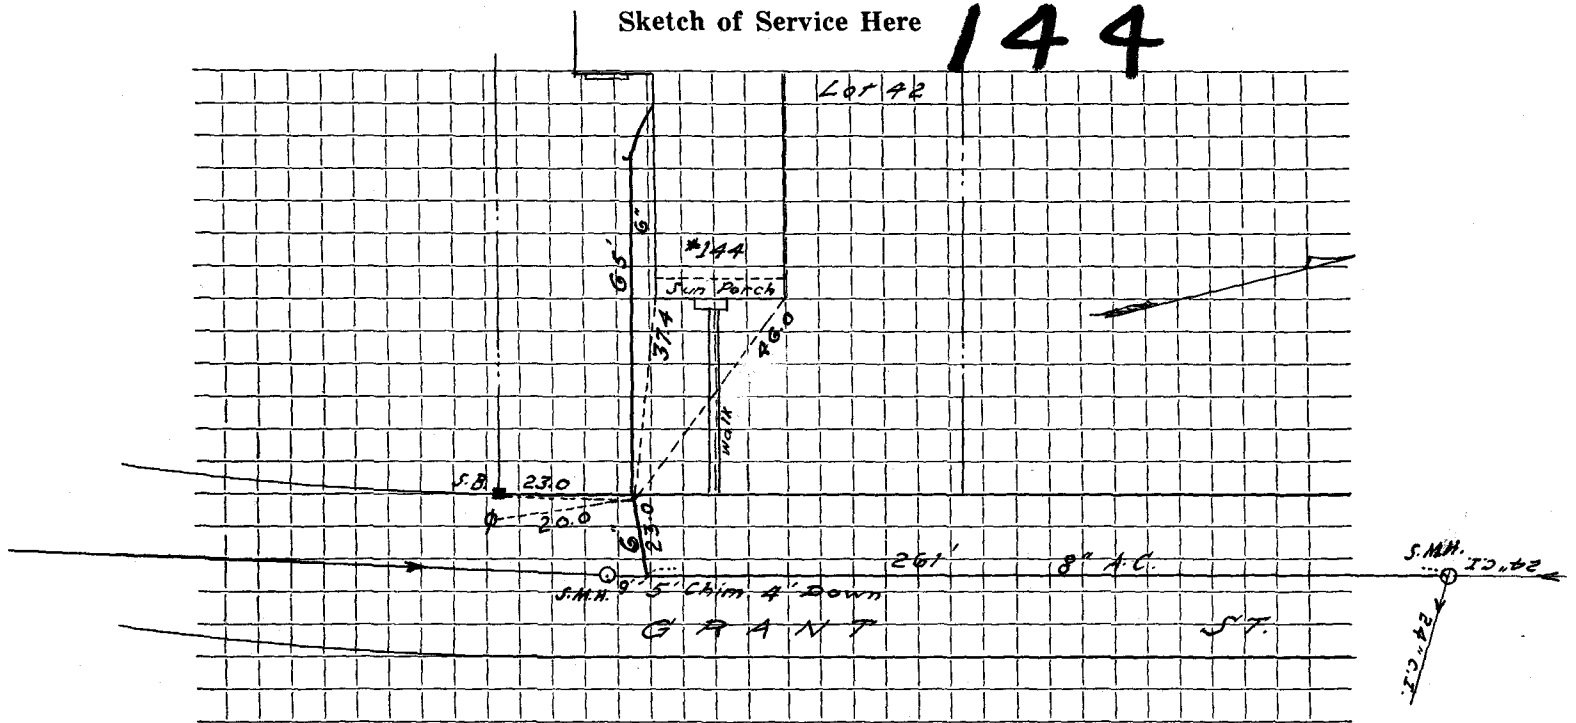

Connection made in Street. Work completed

Remarks:

.....
.....