

Name W. A. Fletcher

Service No. 201

Address 148 Grant Street

Location

Kind of Pipe

Size

Size of Main

~~Repair~~ New Service

Location Comm 12-12-60


Date	Material	Amount	Total	Date	Amount
10-19-60	Labor	83.20		10-4-60	Deposit 200.00
11-19-60	"	15.78	98.98	12-12-60	Retard 3.21
	10% O.H.	9.89	108.87		196.79
	42' 6" Transite pipe @.78		32.76		
	2 22 ¹ / ₂ ° Transite Bend @6.21		12.42		
	1 11 ¹ / ₂ ° Transite Elbow		2.24		
	3 hrs. Town Shovel @6.50		19.50		
	3 hrs. Trucking @3.00		9.00		
	12 x 3 Patch		12.00		
			196.79		

DATE _____

TOWN OF LEXINGTON — BOARD OF PUBLIC WORKS

SEWER DIVISION

Sketch of Service Here

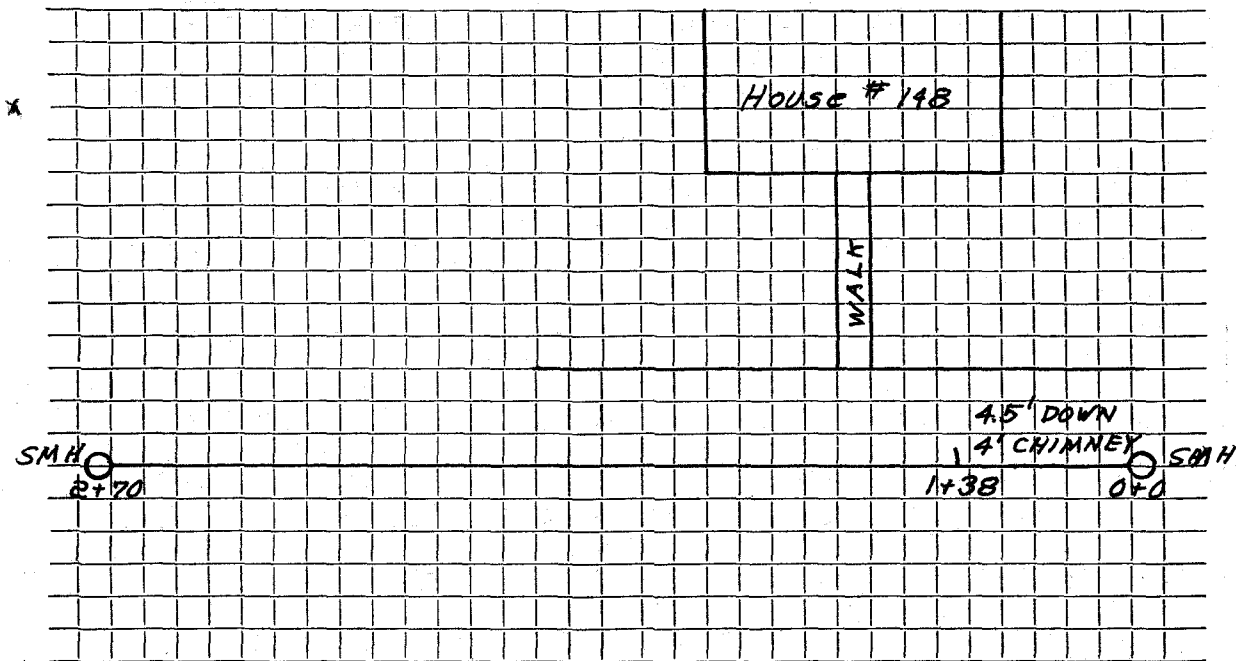

Connection made in Street. Work completed

Remarks:

.....

.....