

Name Leonard W. Williamson

Service No. 48

Address 150 Grant Street

Location

Kind of Pipe

Size

Size of Main

Repair—Renewal—~~REPAIR~~Location *Canon 5-16-60*

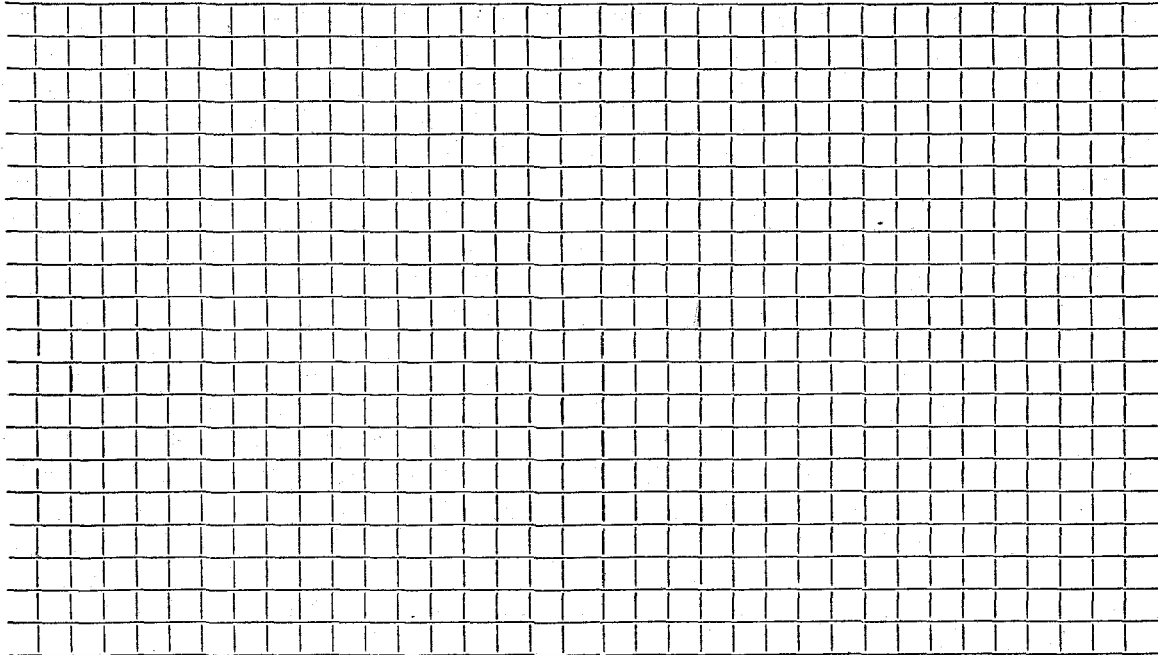
Date	Material	Amount	Total	Date	Amount
5-4-60	Labor 104.16			4-25-60	400 00
	10% O.H. 10.42		114 58	5-16-60	98 00
	118' 6" Transite Pipe @ .78		92 04		302 00
	1 20" Cesspool Cover & Frame		10 50		
	10 3/4 Ton Bank Gravel @ .85		9 13		
	2 22 1/2° Transite Bends @ 6.21		12 42		
	1 6" 90° Elbow		5 29		
	2 Bags Cement @ 1.50		3 00		
	150 Sewer Brick @ 4.20 per hd.		6 30		
	1 22 1/2° Transite Elbow		2 24		
	3 Hrs. Town Shovel @ 6.50		19 50		
	1 Hr. Trojan Loader @ 3.00		3 00		
	4 Hrs. Trucking @ 3.00		12 00		
	12x3 Patch		12 00		
			302 00		

DATE _____

TOWN OF LEXINGTON — BOARD OF PUBLIC WORKS

SEWER DIVISION

Sketch of Service Here

A large grid for sketching service details, consisting of 20 columns and 20 rows of small squares.

Connection made in Street. Work completed

Remarks:
.....
.....