

Name Todd Realty Inc.

Service No. 142

Address 153 Grant Street

Location

Kind of Pipe

Size

Size of Main

~~Repair/ Renewal~~ - New Service W.O. #7584

Location *Comm 10-29-62*


Date	Material	Amount	Total	Date	Amount
9-10-62	Labor	40.95		9-7-62	Deposit 150 00
	10% O.H.	4.10	45.05	10-29-62	ReFund 13 28
	94' 6" Transite pipe @.82		77.08		136 72
	1 90° Transite Elbow		4.09		
	1 6 x 24 Service Saddle		7.50		
	1 hr. Trucking @3.00		3.00		
			136.72		

DATE _____

TOWN OF LEXINGTON — BOARD OF PUBLIC WORKS

SEWER DIVISION

Sketch of Service Here

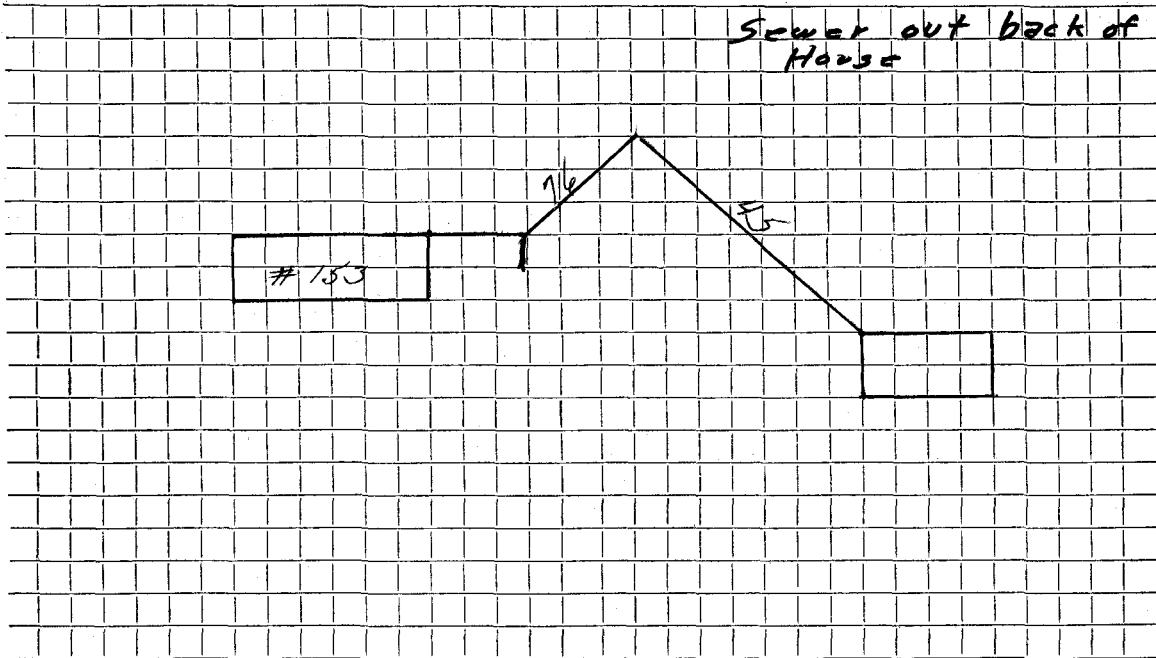

Connection made in Street. Work completed

Remarks:
.....
.....