

Name

Service No.

Address

164 GRANT ST

Location

Kind of Pipe

Size

Size of Main

Repair—Renewal—New Service

Location


Date	Material	Amount	Total	Date	Amount
4-30-07	10' - 4" PVC			6-16-97	Repair made
	39' - 6" PVC				
	4x6 PVC FERNCO				
	6x6 PVC to AC FERNCO				
					11' - 6" PVC
					1- 6" PVC to PVC FERNCO
					1- 6" PVC to AC FERNCO
					1- 6" PVC 90° Bend

DATE _____

TOWN OF LEXINGTON — BOARD OF PUBLIC WORKS

SEWER DIVISION

Sketch of Service Here

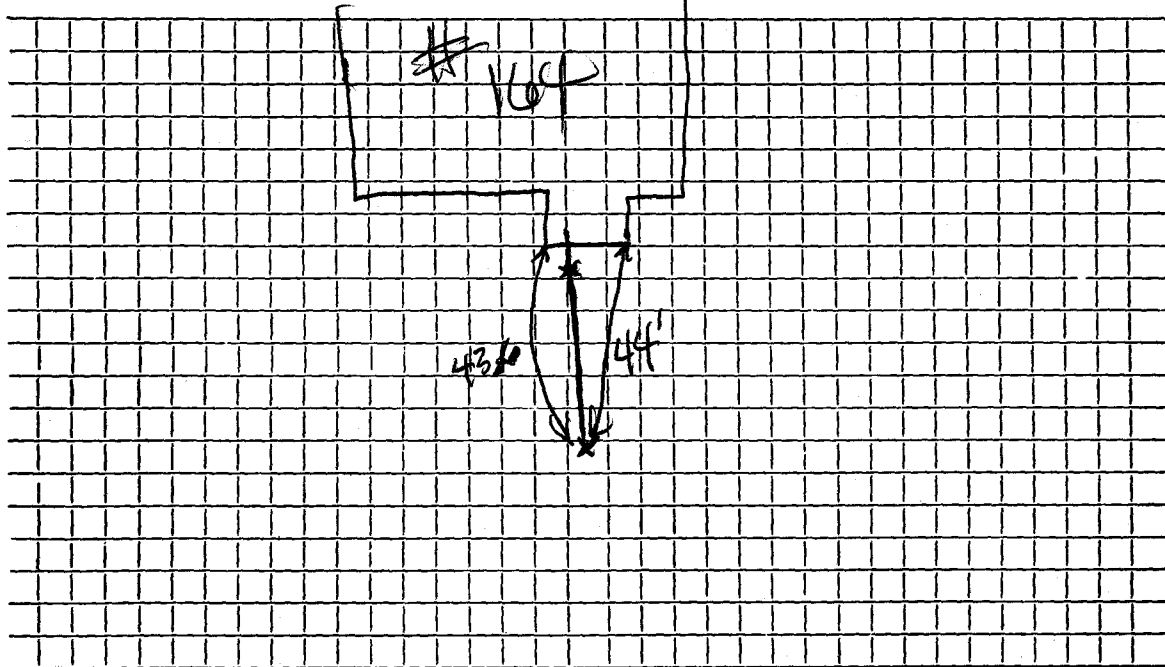

Connection made in Street. Work completed

Remarks:

.....

.....