


DATE _____

TOWN OF LEXINGTON — BOARD OF PUBLIC WORKS
SEWER DIVISION

Sketch of Service Here

J. McLaughlin

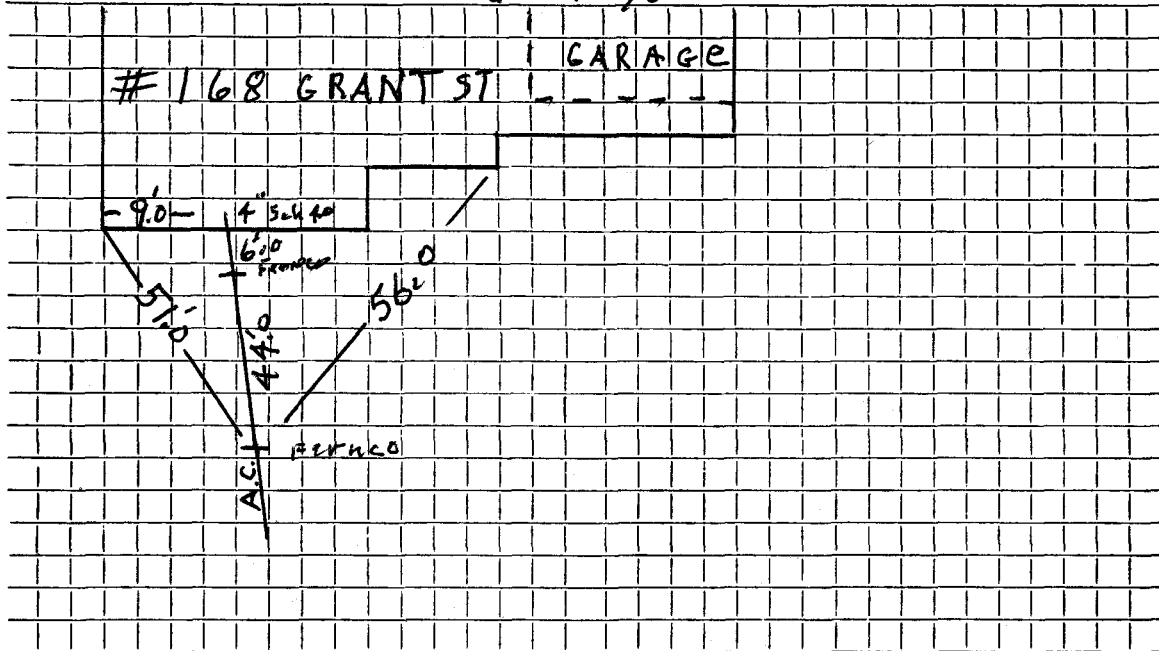

Connection made in Street. Work completed 10/27/04.....

Remarks:

.....

.....