

Name Eugene P. Carter

Service No. 40

Address 180 Grant Street

Lot 10

Location

Kind of Pipe

Size

Size of Main

Repair—Renewal—New Service Russell Sibley Construction Co. #2647

Location AUG 16 1976

Date	Material	Amount	Total	Date		Amount
Jun '67	19' 6" Transite pipe @6.00		114.00	5-15-75	<i>Deposit</i>	114.00
5/29/75	107' 6" Transite Pipe					
	11.5' 4" Cast Iron Pipe			6- -67		
				19' 6" Transite		


DATE _____

TOWN OF LEXINGTON — BOARD OF PUBLIC WORKS

SEWER DIVISION

Sketch of Service Here

180

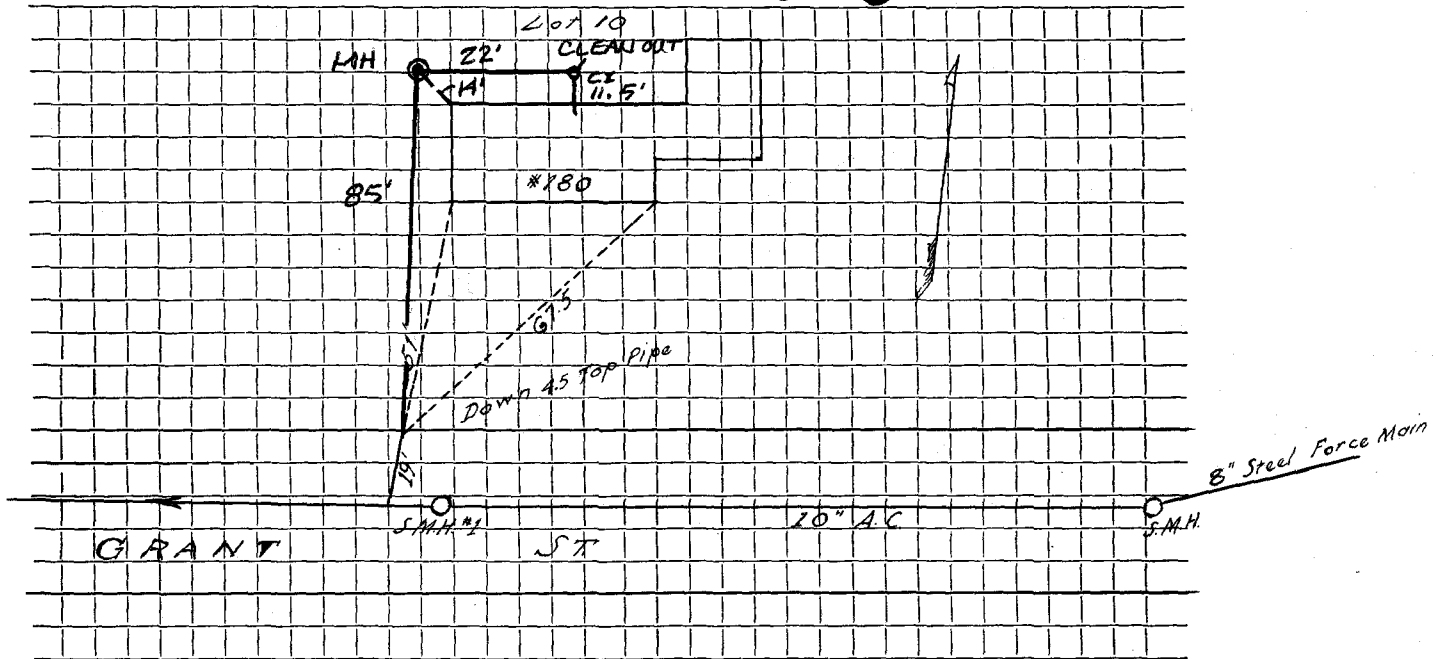

Connection made in ... GRANT ST ... Street. Work completed ... 5-29-75 ...

Remarks:

.....

.....