


DATE _____

TOWN OF LEXINGTON — BOARD OF PUBLIC WORKS

SEWER DIVISION

Sketch of Service Here

CAR,

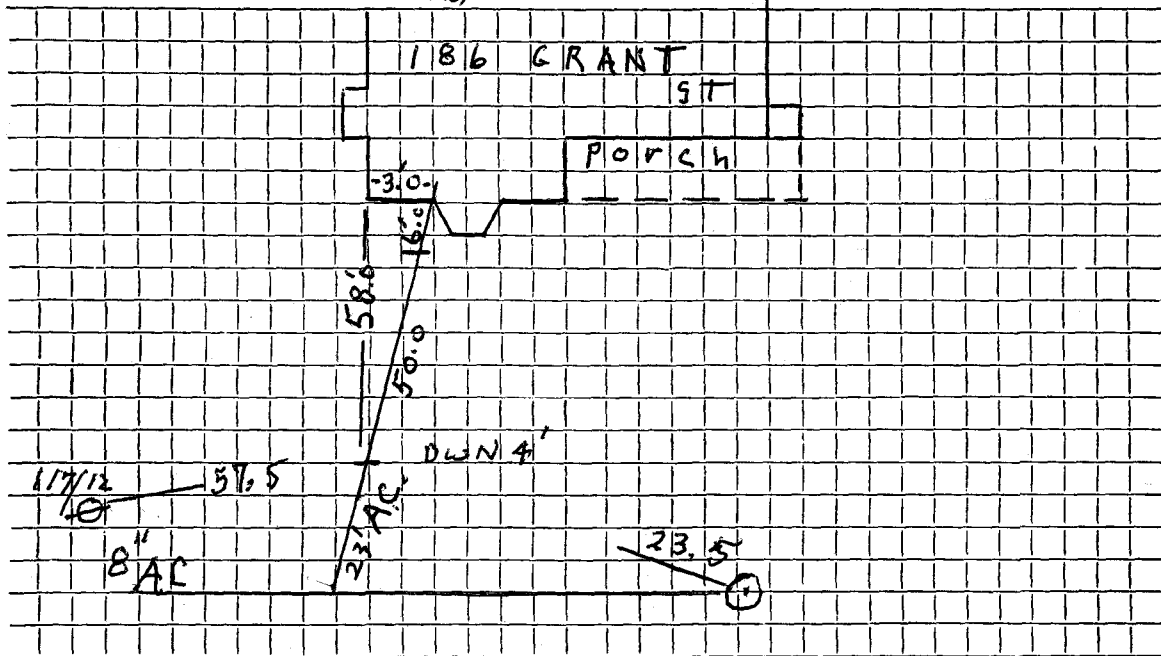

Connection made in Street.

Work completed 10/20/04 J. McC...
.....
.....

Remarks: A.C. info. off. old card
.....
.....