




DATE \_\_\_\_\_

TOWN OF LEXINGTON — BOARD OF PUBLIC WORKS

SEWER DIVISION

Sketch of Service Here

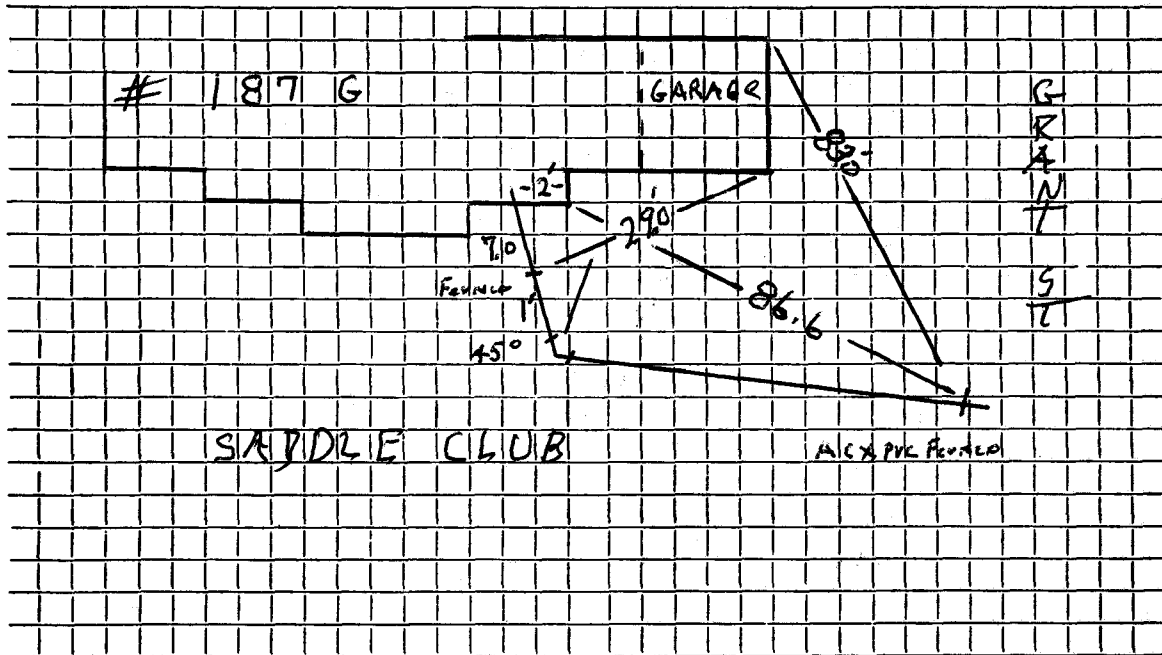

Connection made in ..... Street.

Work completed 7/20/06 J. McLaughlin...

Remarks: .....  
.....  
.....