

Name Elliot I. Mishara

Service No.

158(75)

Address # 193 GRANT ST.

Location

Kind of Pipe A.C.

Size 6"

Size of Main 8"

Repair—Renewal New Service


Valeri #2933

Location AUG 16 1976

Date	Material	Amount	Total	Date		Amount
<del>12/8/75</del>	<del>26 L.F. Cl. 3300</del>	<del>*260.00</del>		12/9/5	Deposit	260 00
	0 10.00 L.F.					
12/8/75	56' 6" Transite Pipe			12-8-75		
	14' 4" Cast Iron Pipe			26' 6" cl. 3300		

DATE \_\_\_\_\_

TOWN OF LEXINGTON — BOARD OF PUBLIC WORKS  
SEWER DIVISION

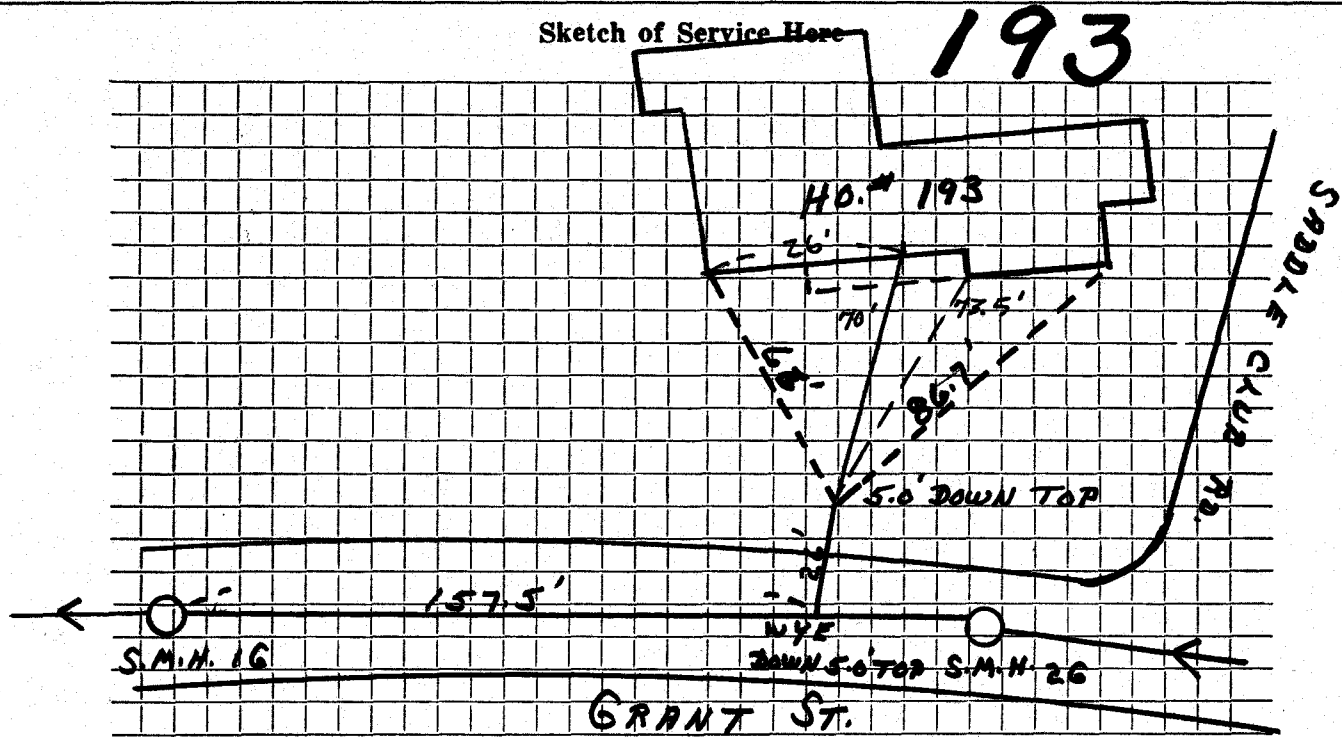

Connection made in ..... GRANT ..... Street. Work completed ... 12 - 8 - 75 .....

Remarks: .....

.....

.....